



Hudson SWEF

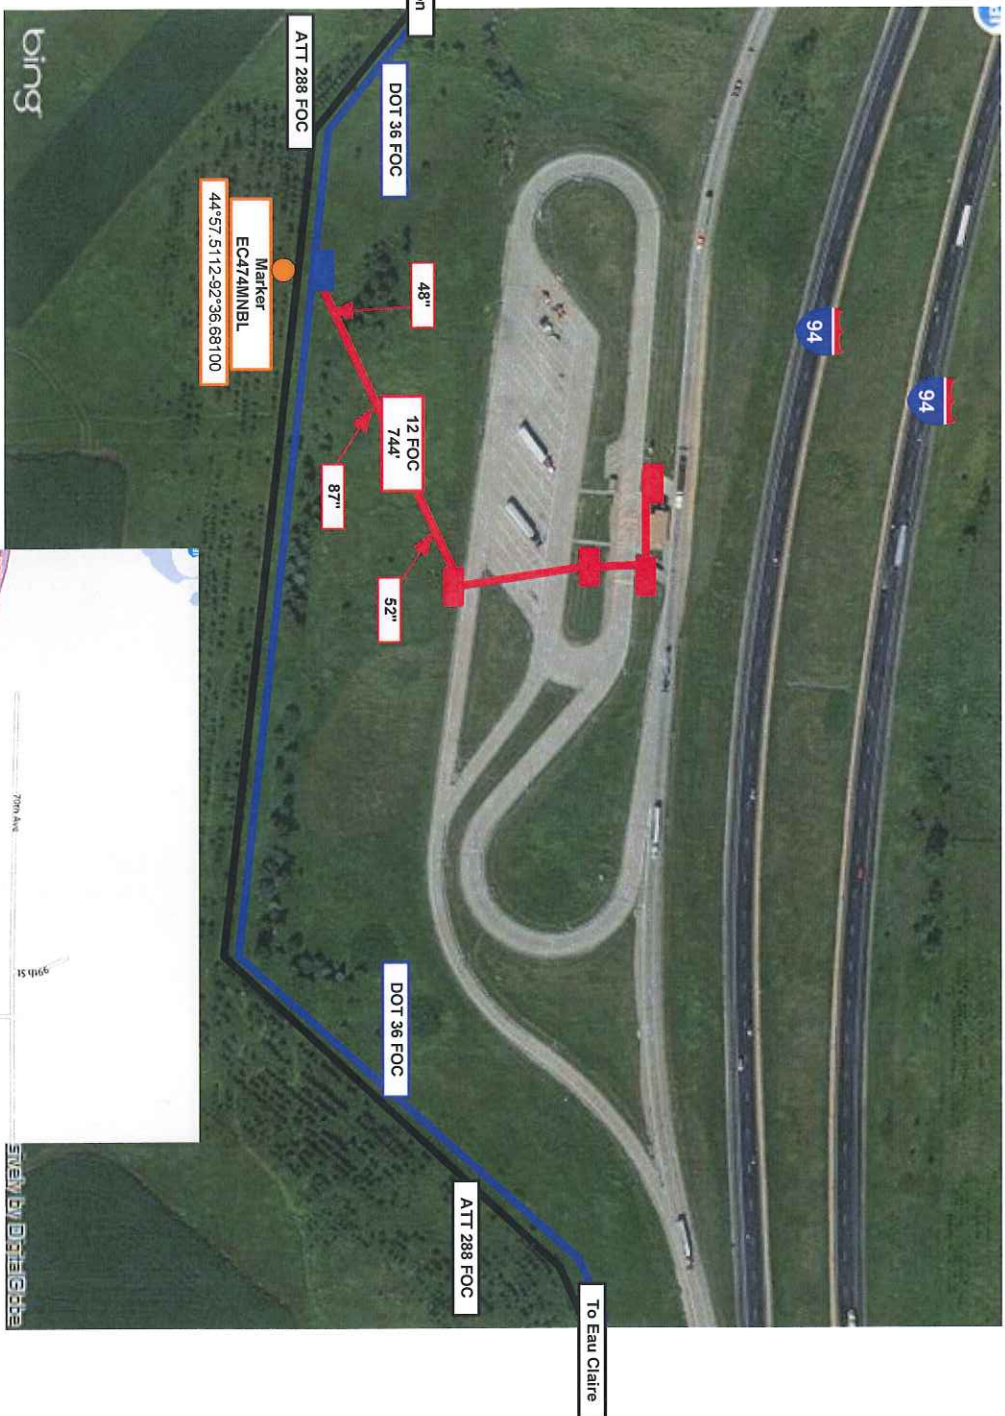

Legend	
HH	Fiber Handhole
■	New HH
■	Existing HH
—	New MIN Fiber
—	DOT Fiber

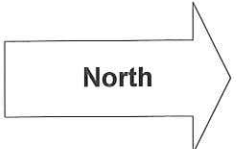

Dwg 1
CLNet
Revised 12-26-2012
Hudson SWEF.vsd