

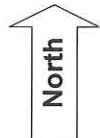


# Locate Key Map

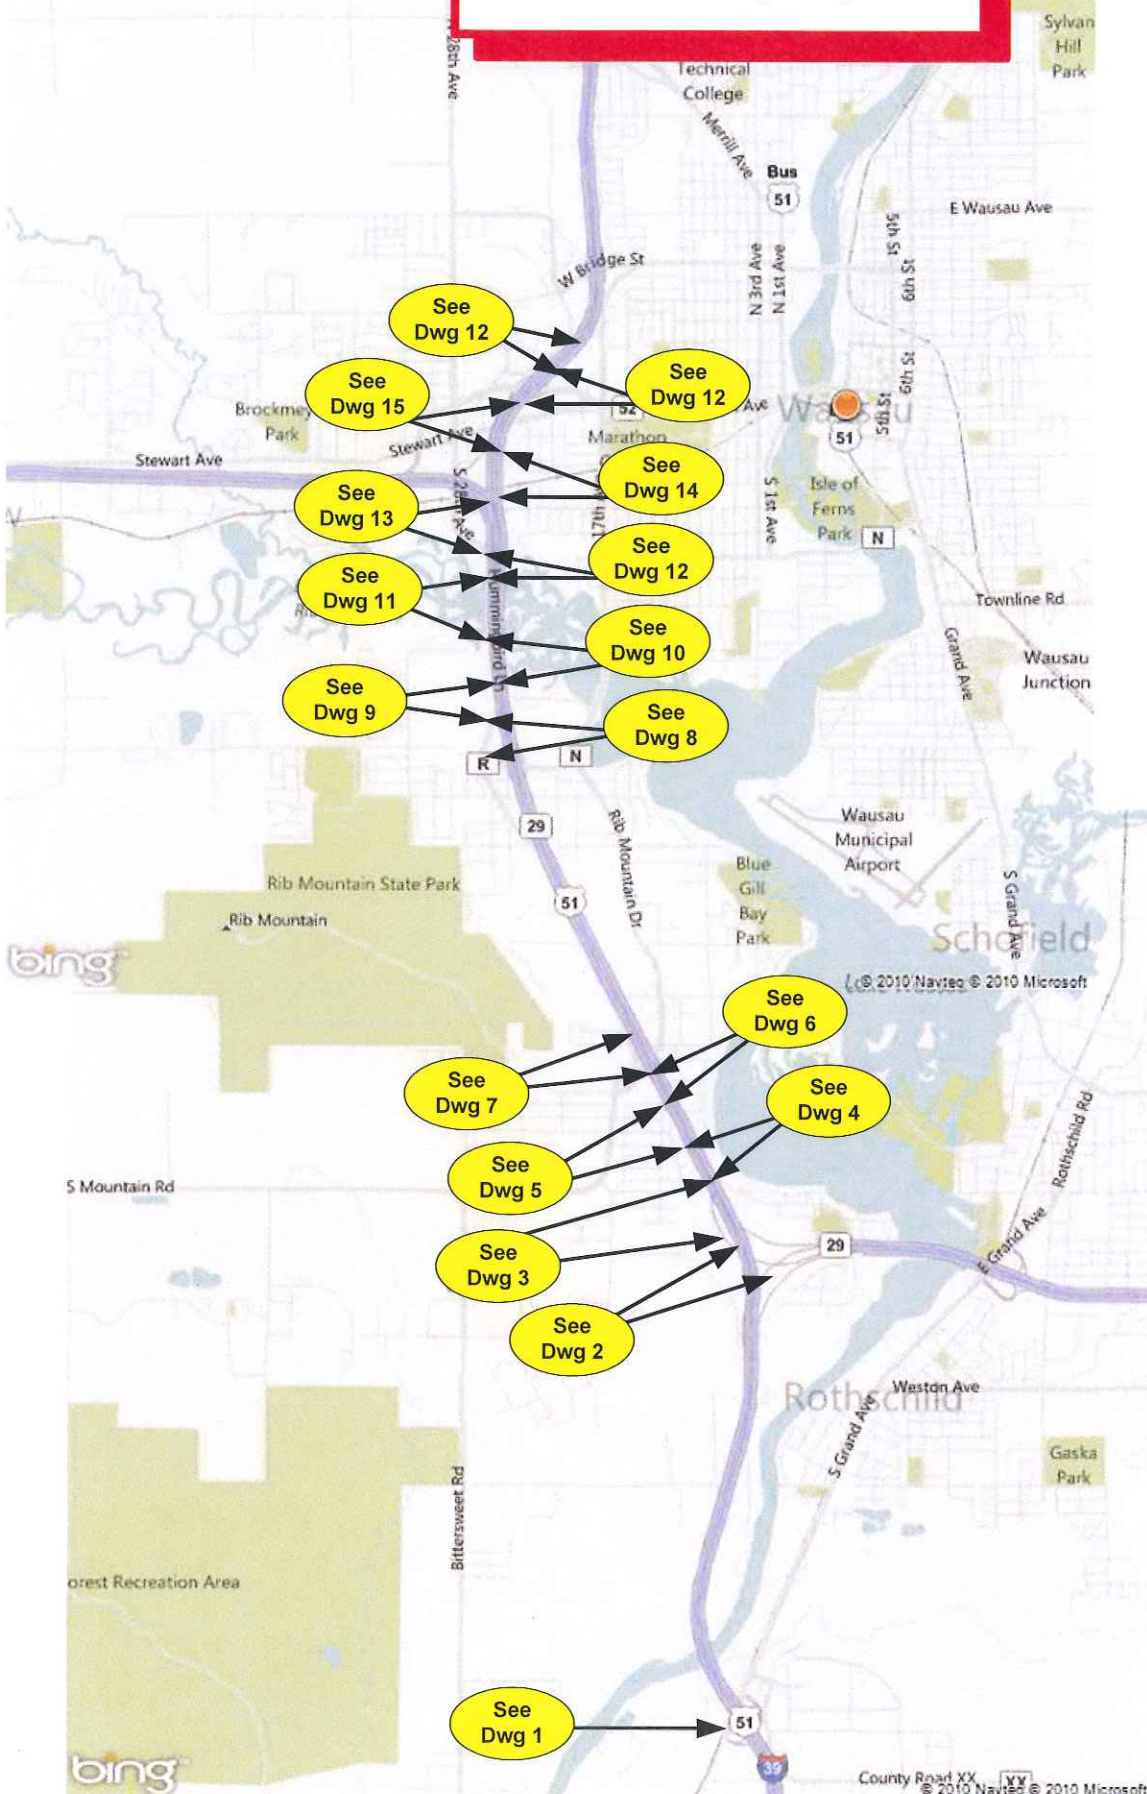


CLNet		
Revised	8-30-2010	

Key Map I-39 Locates Wausau.wsd

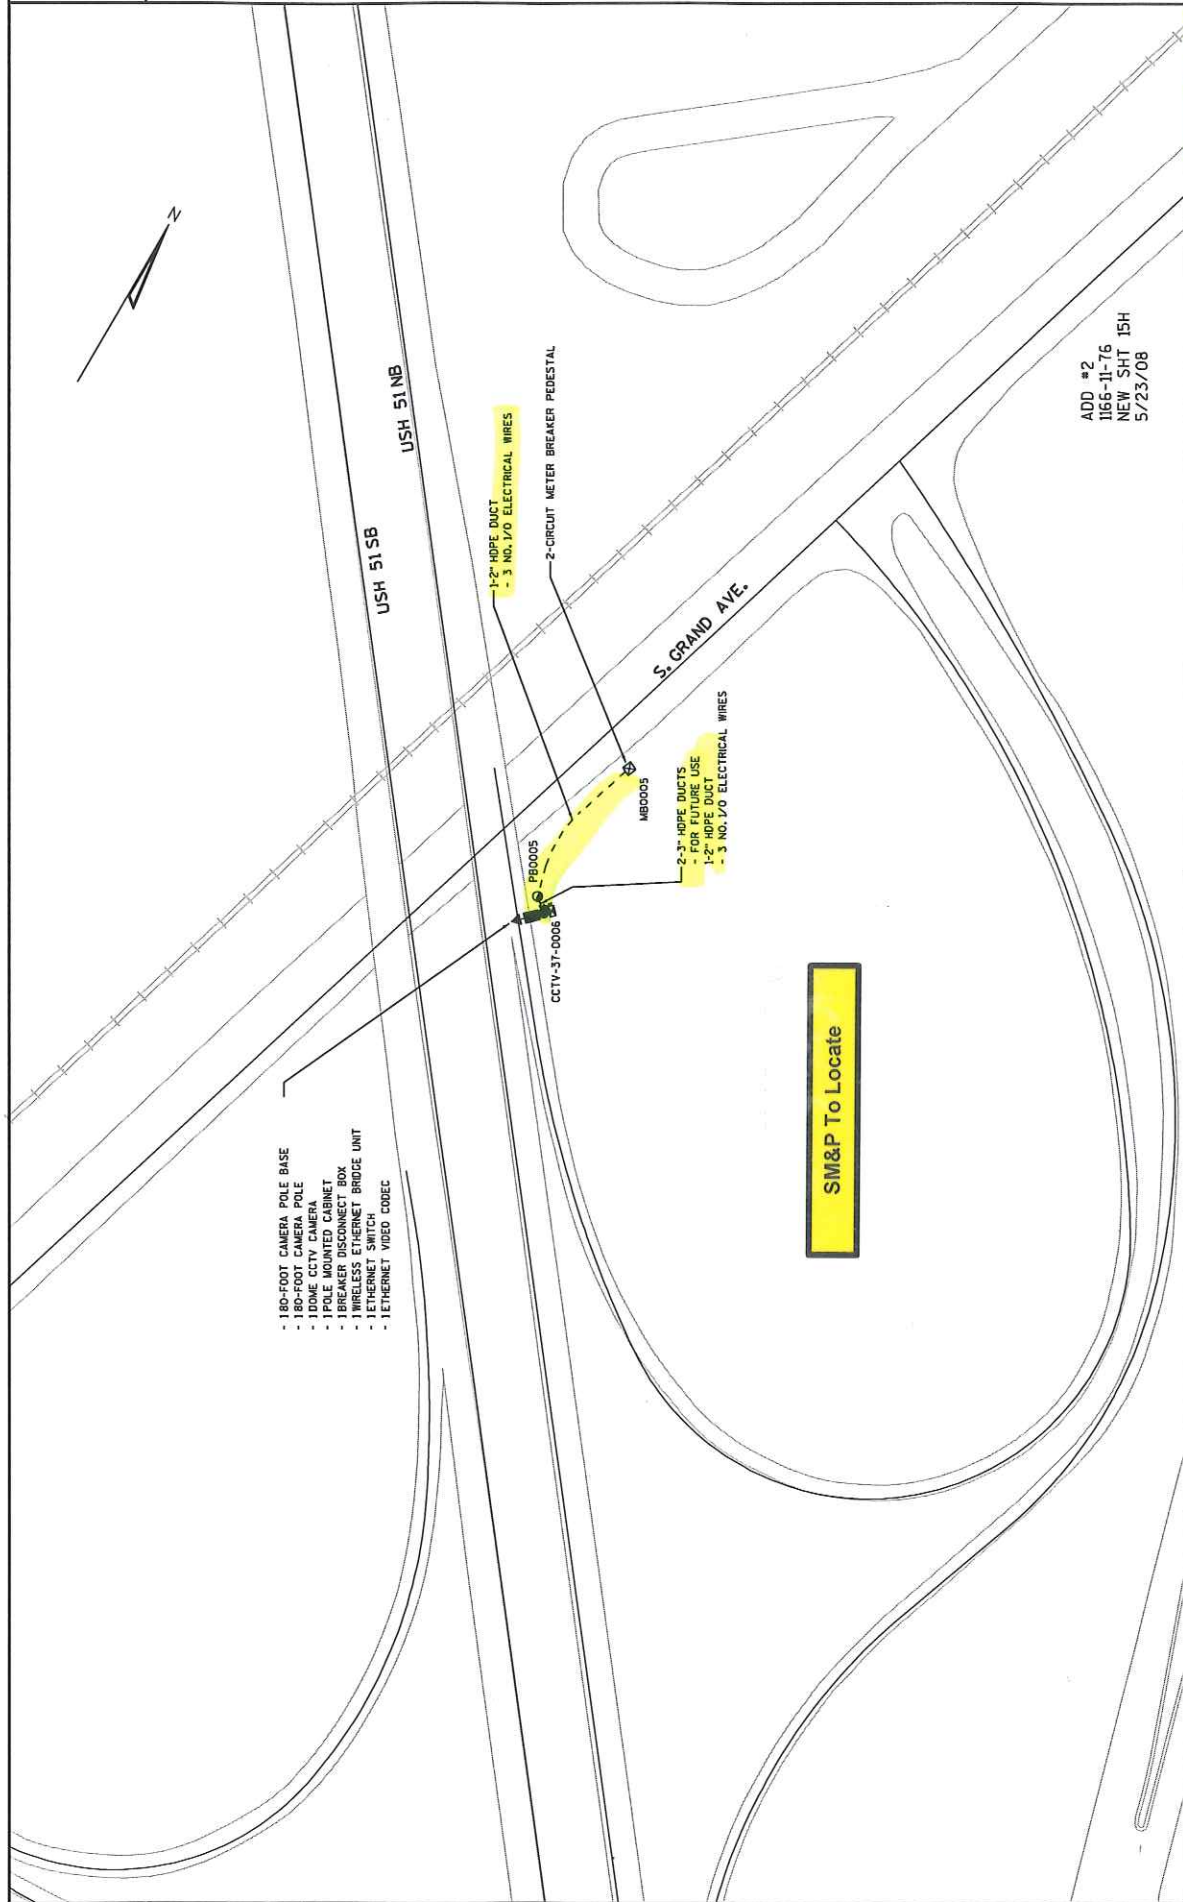



2

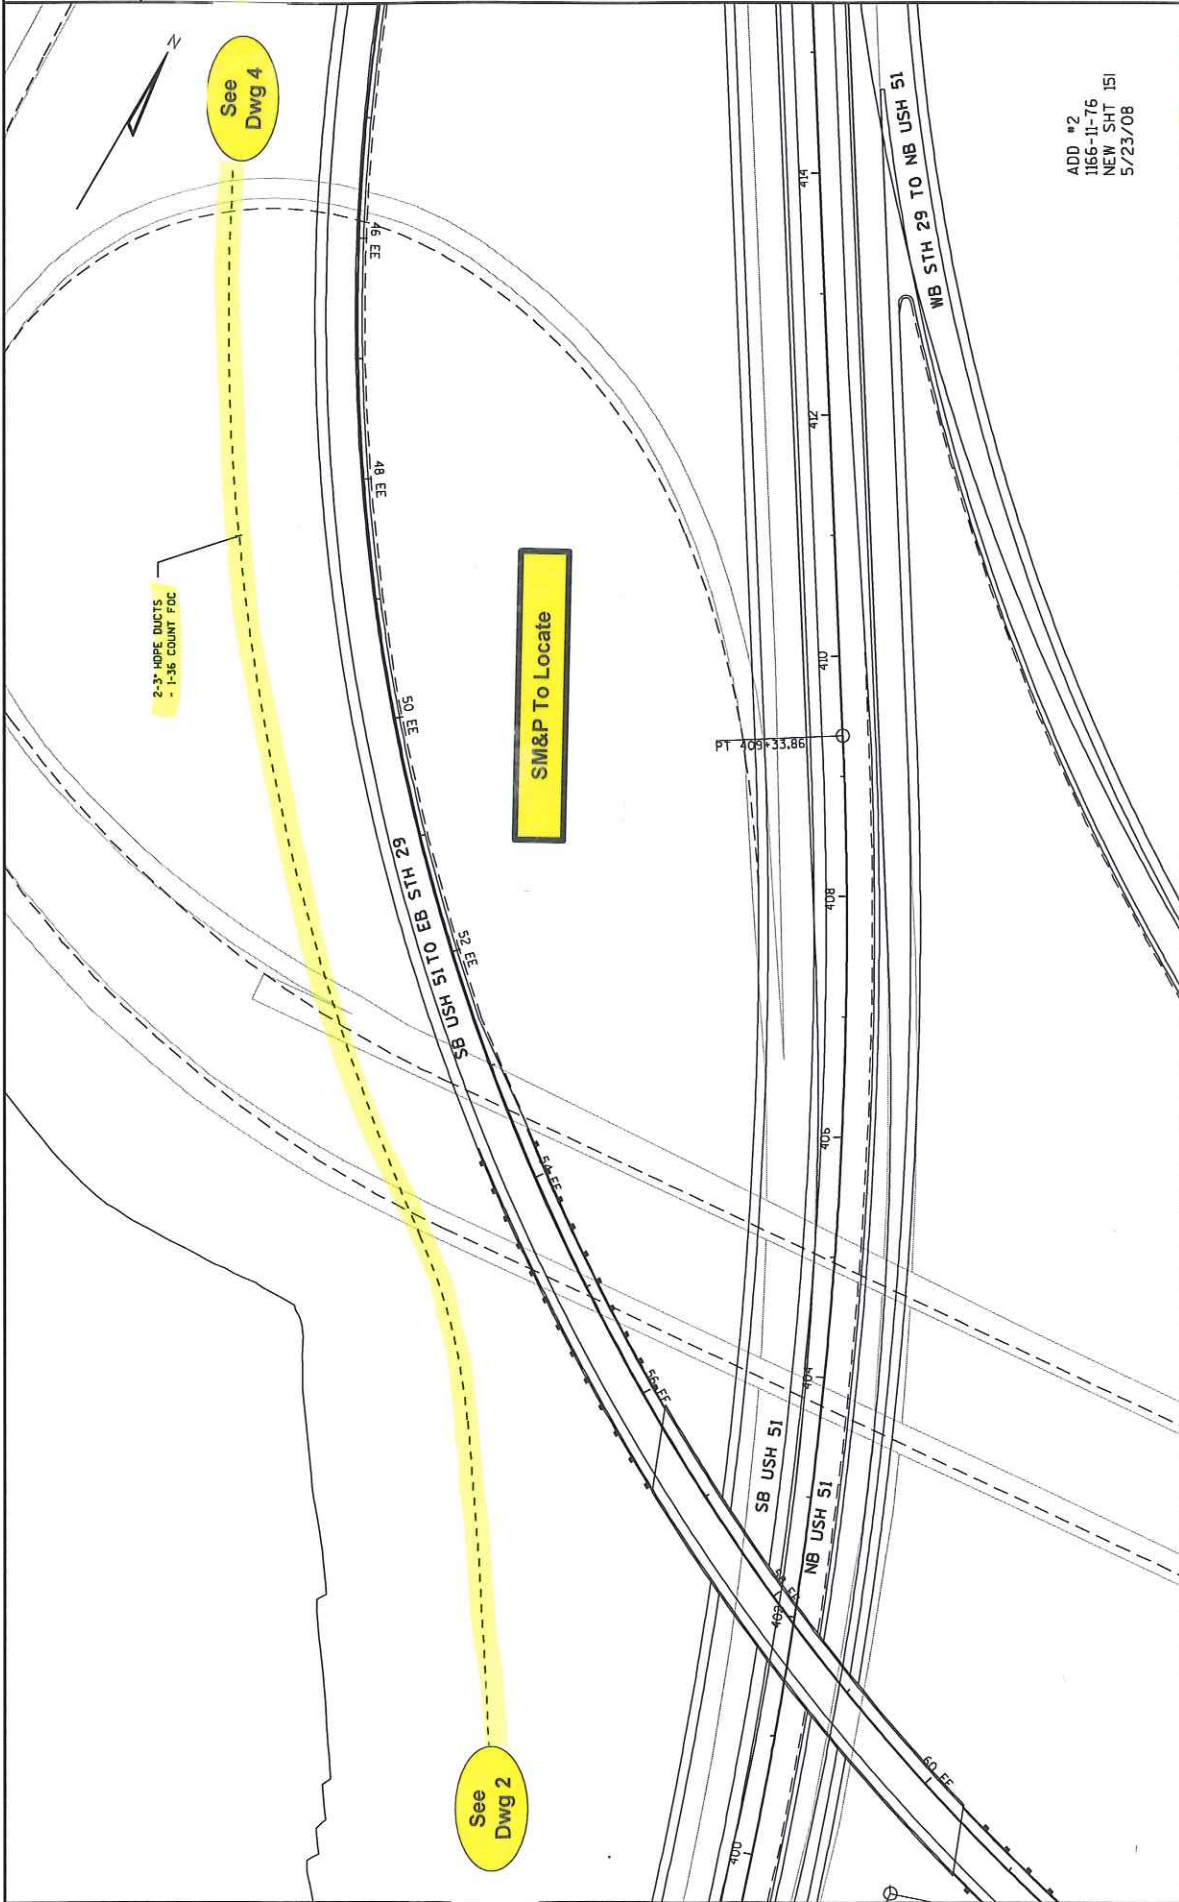

See Dwg 4

2-3" HOPE DUCTS  
- 1-36 COUNT FOC

SM&P To Locate

See Dwg 2

ADD #2  
1166-11-76  
NEW SHT 151  
5/23/08



See Dwg 3

2-3" HOPE DUCTS  
- 1'-36" COUNT FOC

SM&P To Locate

See Dwg 5

SB USH 51 TO EB STH 29

SB USH 51

NB USH 51

WB STH 29 TO NB USH 51

44 EE

42 EE

40 EE

PC 32+50.25 EE

PT 31+30.64 EE

PI EB CV0200


PC 41+04.49 EE

ADD #2  
1166-11-76  
NEW SHT 15J  
5/23/08

PROJECT NO: 1166-11-76	COUNTY: MARATHON	ITS PLANS	SHEET 40517 E
HWY: USH 51 / STH 29	PLOT BY: PRUTZ	PLOT NAME:	WSDOT/CADD SHEET 42
FILE NAME: I:\1166\1166\1166\1166\CADD\CADD\CD5-ITS-003.dwg	PLOT DATE: 22-MAY-2008 16:00	PLOT SCALE: 100.0000911.000000	



2

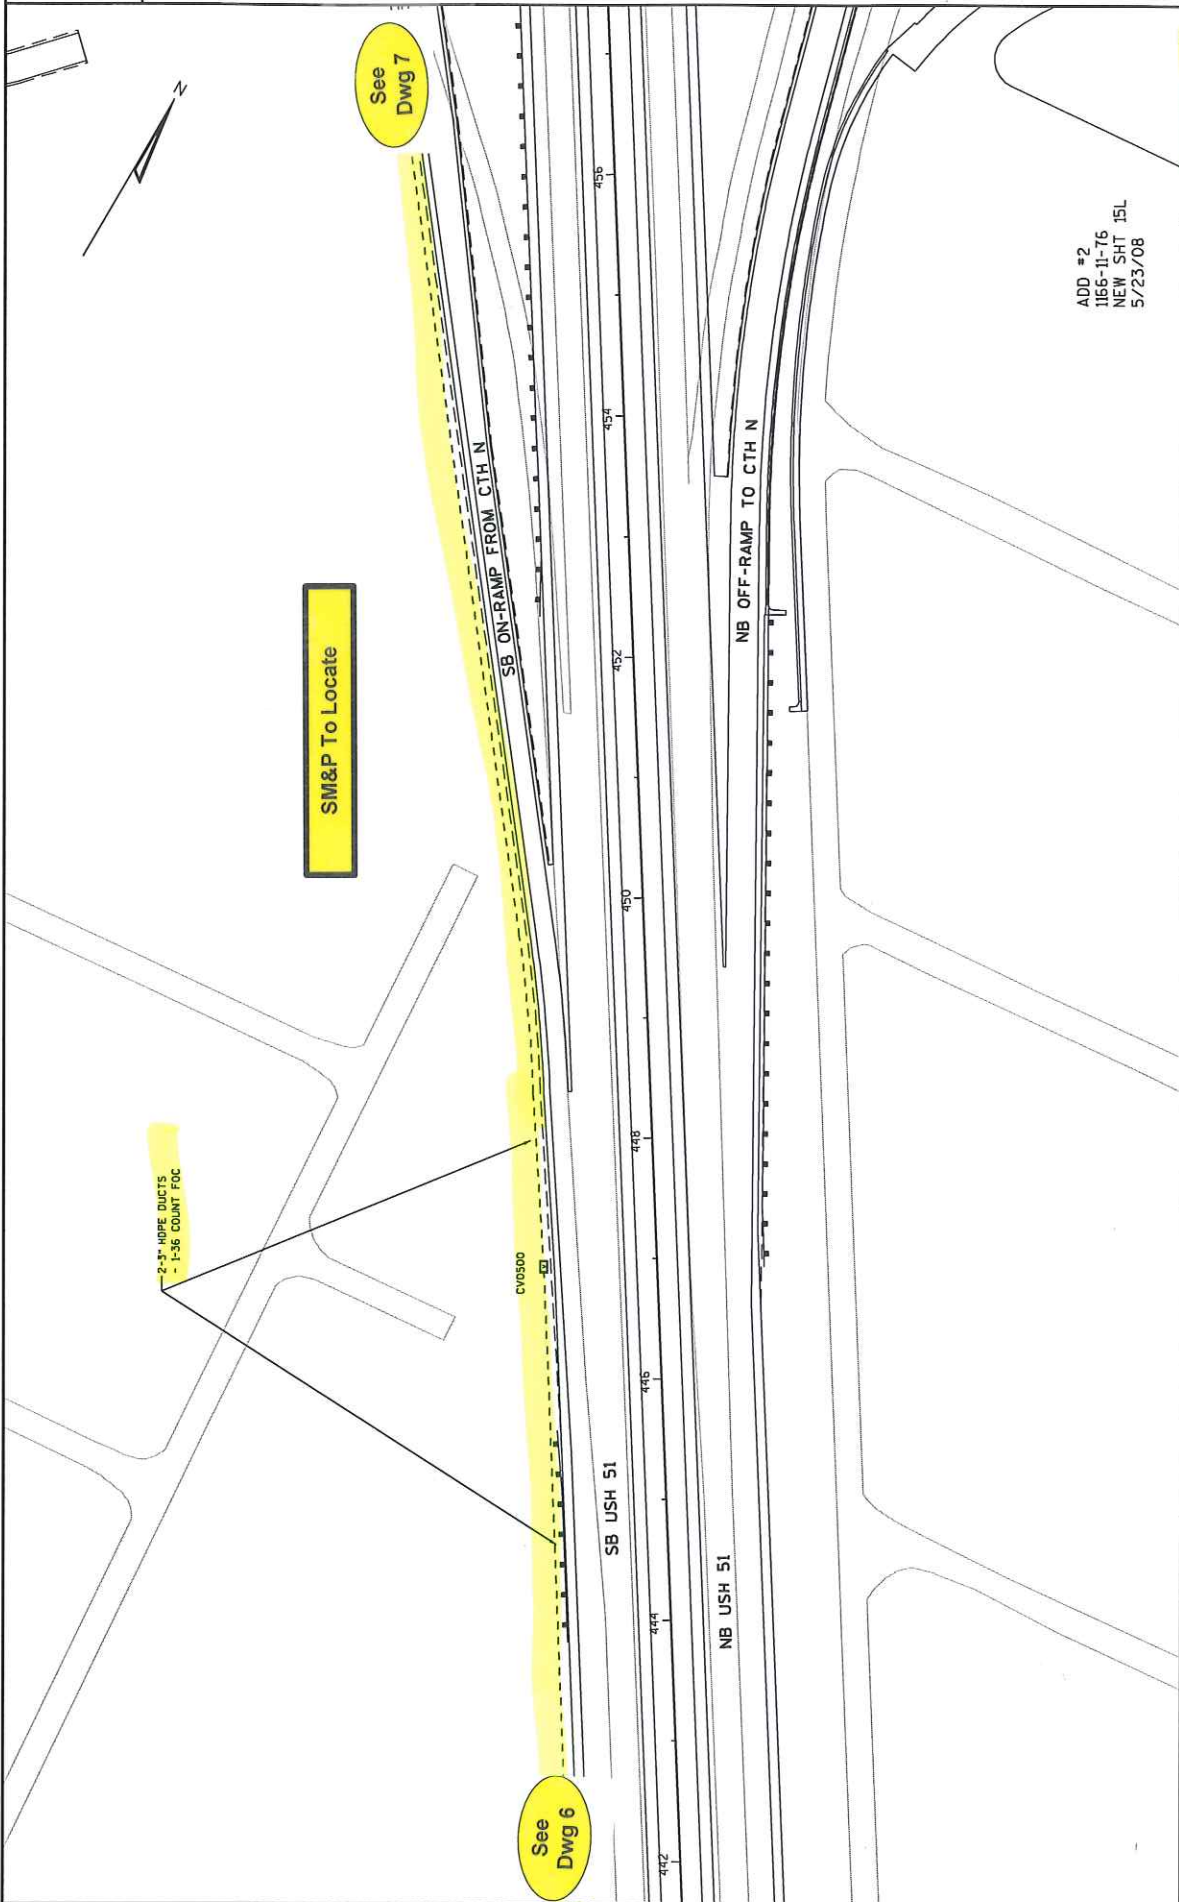

2

SM&P To Locate

See Dwg 7


See Dwg 6

2\"/>

ADD #2  
1166-11-76  
NEW SHT 15L  
5/23/08

PROJECT NO: 1166-11-76	HWY: USH 51 / STH 29	COUNTY: MARATHON	ITS PLANS	SHEET 66F17 E
FILE NAME : I:\V3555\NUGUN\0861\CV\CADD\085-ITS-005.dgn				
PLOT DATE : 22-MAY-2008 16:05				
PLOT BY : PKUTZ				
PLOT SCALE : 100.00004911:00000				
WISDOT/CADD SHEET 42				



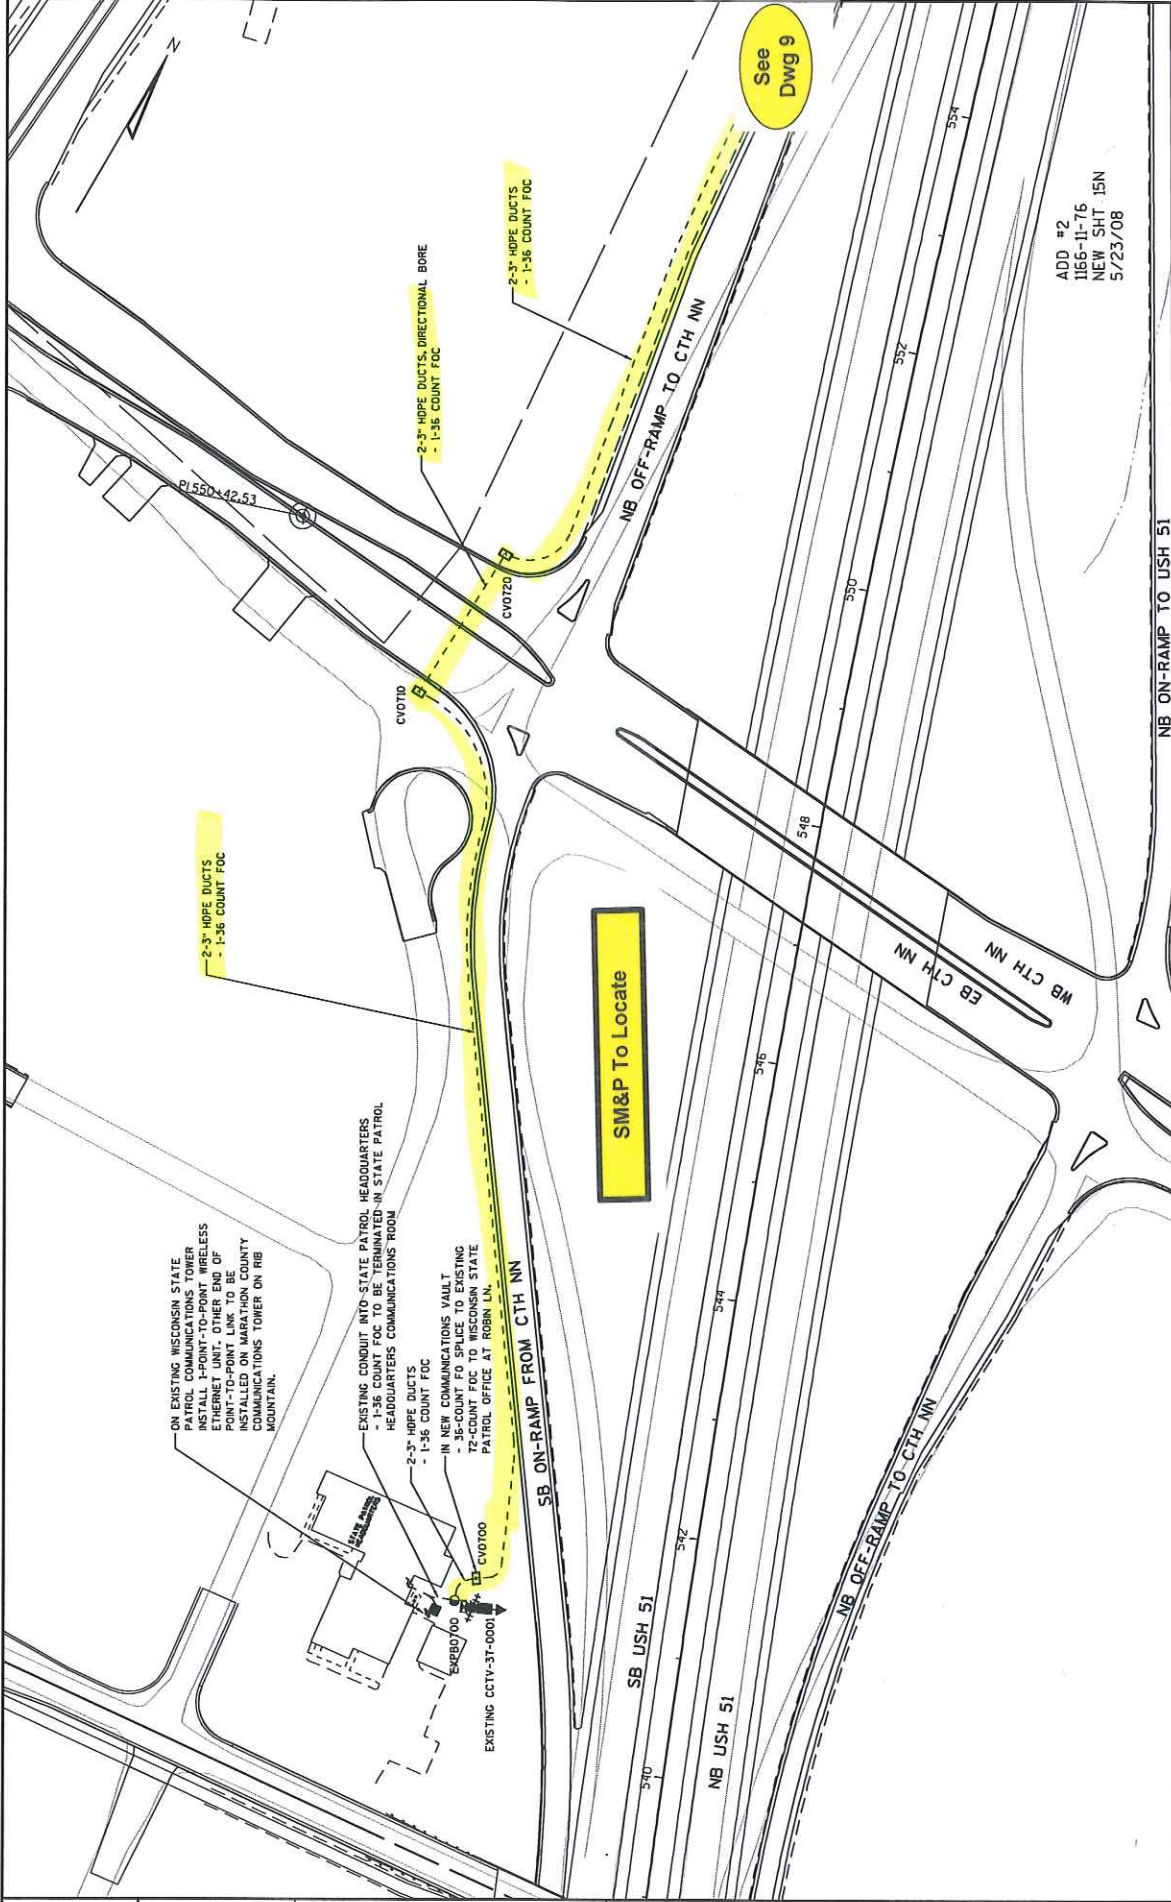

ON EXISTING WISCONSIN STATE PATROL COMMUNICATIONS TOWER INSTALL 1-POINT-TO-POINT WIRELESS ETHERNET UNIT. OTHER END OF POINT-TO-POINT LINK TO BE INSTALLED ON MARATHON COUNTY COMMUNICATIONS TOWER ON RIB MOUNTAIN.

EXISTING CONDUIT INTO STATE PATROL HEADQUARTERS HEADQUARTERS COMMUNICATIONS ROOM

- 1-36 COUNT FOC TO BE TERMINATED IN STATE PATROL HEADQUARTERS COMMUNICATIONS ROOM
- 2-3\" HOPE DUCTS
- 1-36 COUNT FOC

IN NEW COMMUNICATIONS VAULT

- 35-COUNT FOC SPLICE TO EXISTING 72-COUNT FOC TO WISCONSIN STATE PATROL OFFICE AT ROBIN LN.

EXISTING CCTV-3T-000


**SM&P To Locate**

See Dwg 9

ADD #2  
1166-11-76  
NEW SHT 15N  
5/23/08

PROJECT NO: 1166-11-76	HWY: USH 51 / STH 29	COUNTY: MARATHON	ITS PLANS	SHEET 8 OF 17	E
FILE NAME : I:\3355\NAMES\0819\CADDS\085-ITS-.001.dgn					
PLOT DATE : 22-MAY-2008 16:12					
PLOT BY : PHUTZ					
PLOT SCALE : 100.00009211.00000					
WISDOT/CADDS SHEET 42					

2

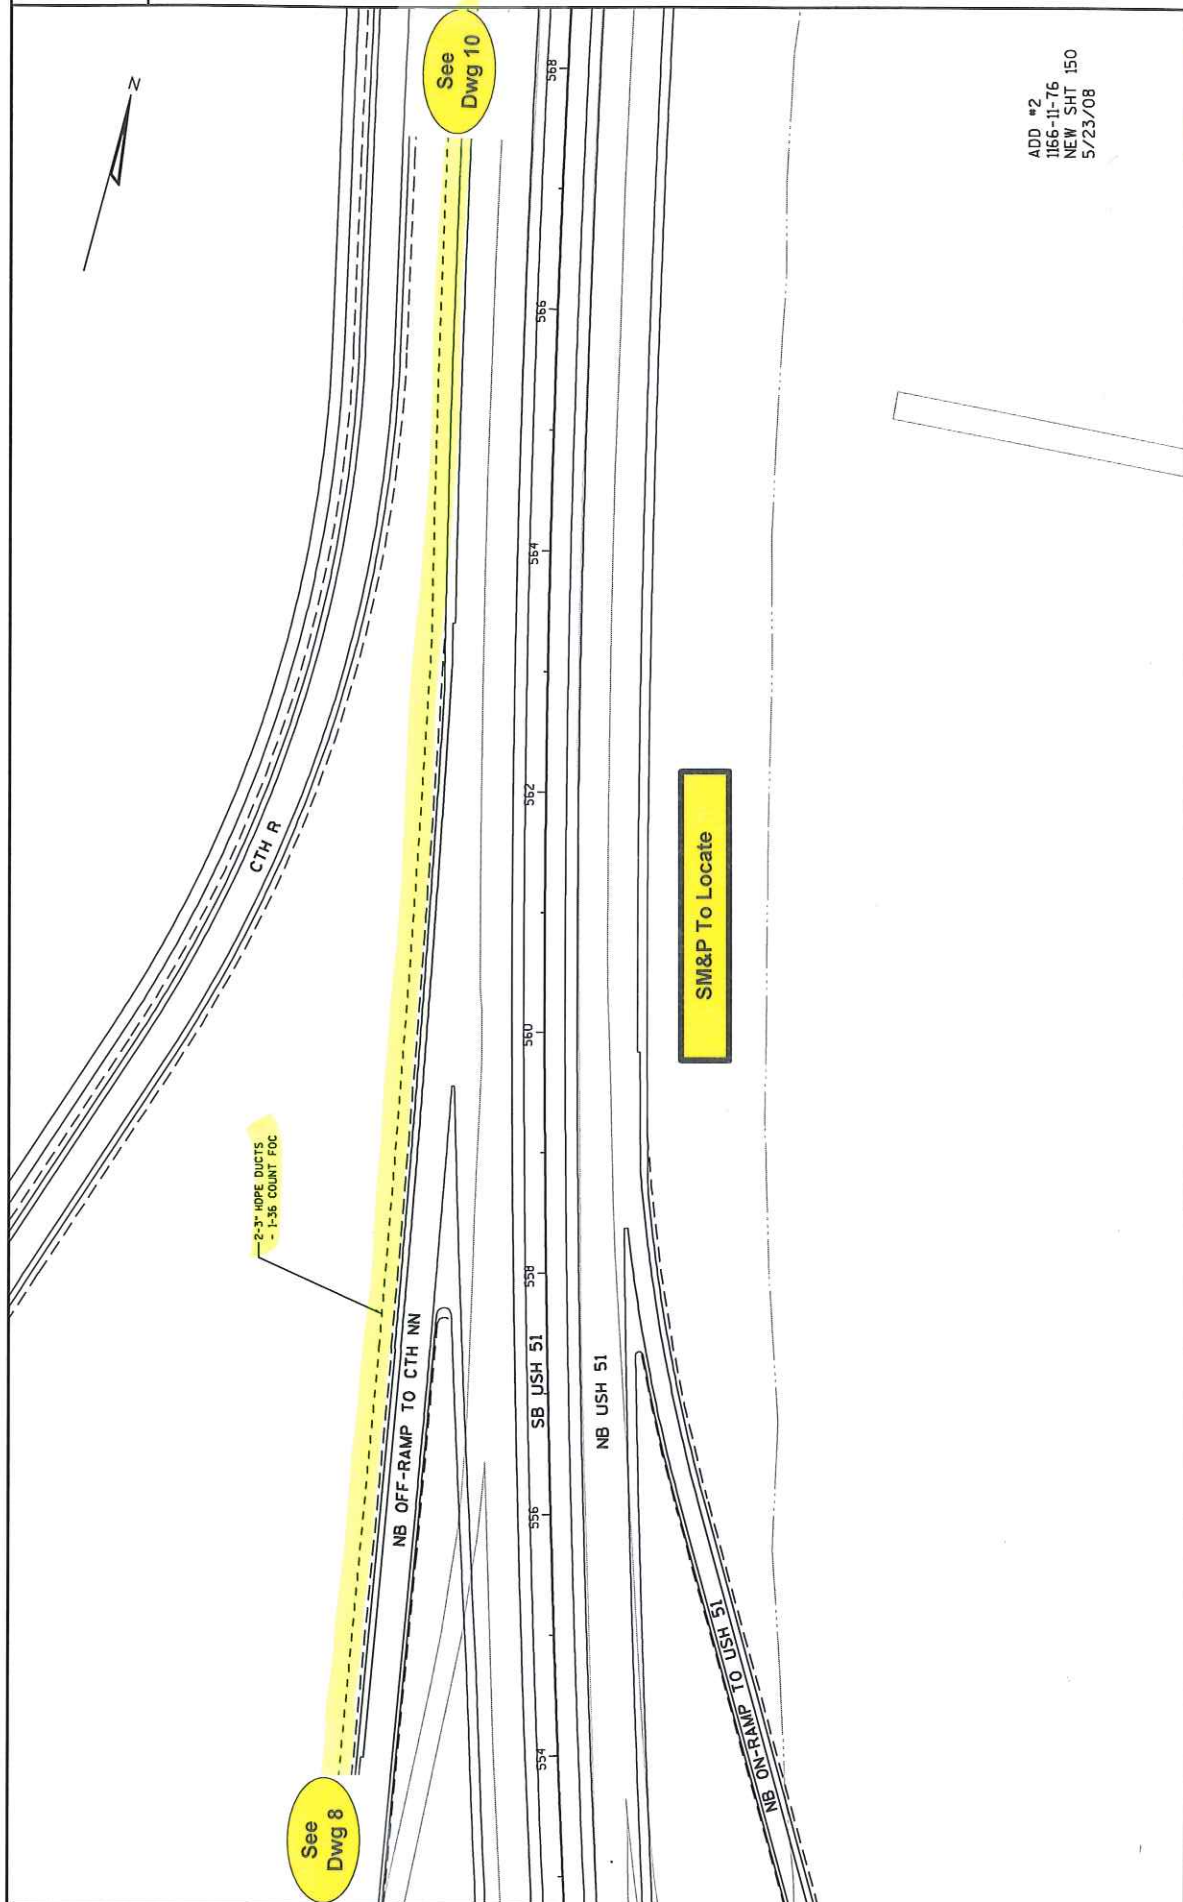

See Dwg 8

See Dwg 10


SM&P To Locate

2-3" HOPE DUCTS  
- 1-36 COUNT FOC


ADD #2  
1166-11-76  
NEW SHT 150  
5/23/08

2

PROJECT NO: 1166-11-76	HWY: USH 51 / STH 29	COUNTY: MARATHON	ITS PLANS	SHEET 90817	E
FILE NAME : I:\V3553\WISDOT\CADD\DRS\1166-11-76-150.DWG					
PLOT DATE : 22-MAY-2008 16:15					
PLOT BY : PKUTZ					
PLOT NAME :					
PLOT SCALE : 100.000072:1.000000					
WISDOT/CADD SHEET 42					

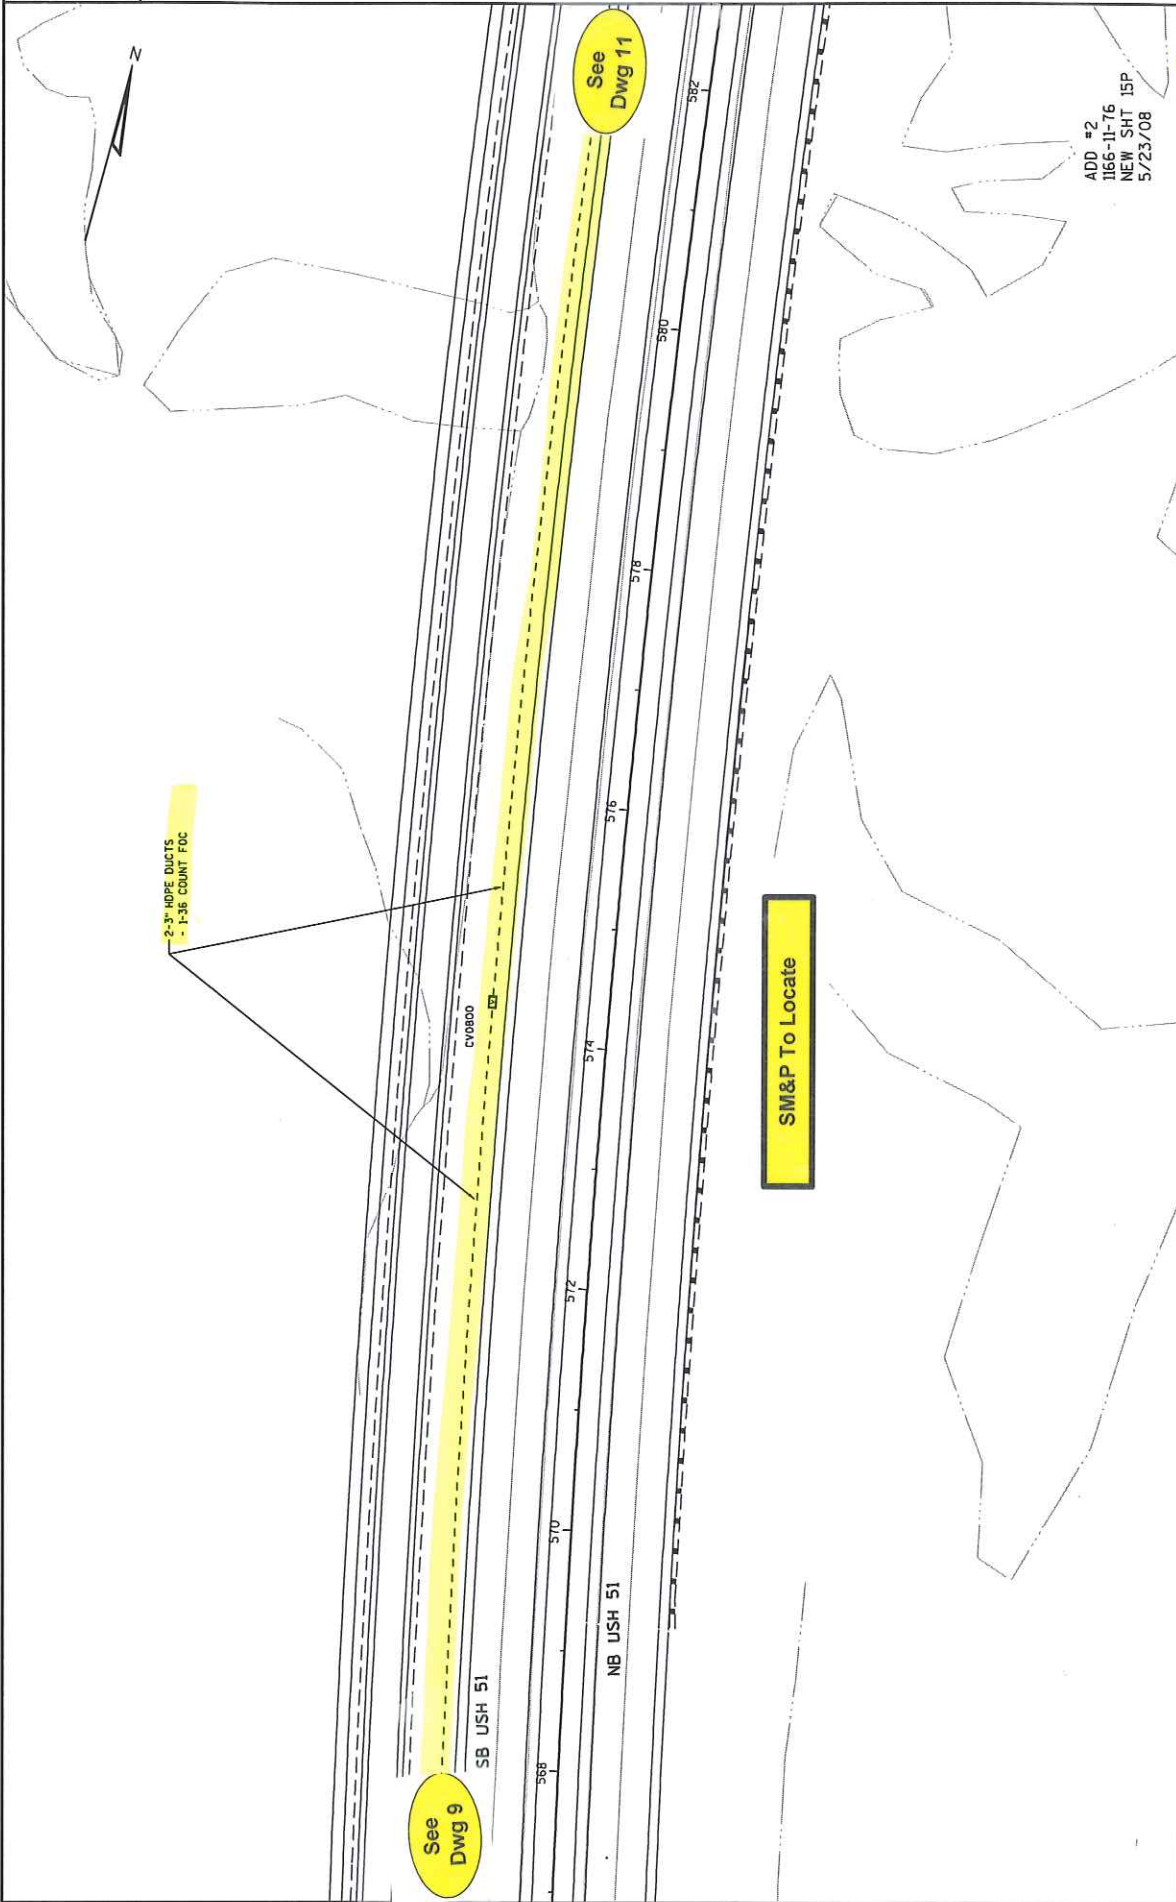

ADD #2  
 1166-11-76  
 NEW SHT ISP  
 5/23/08

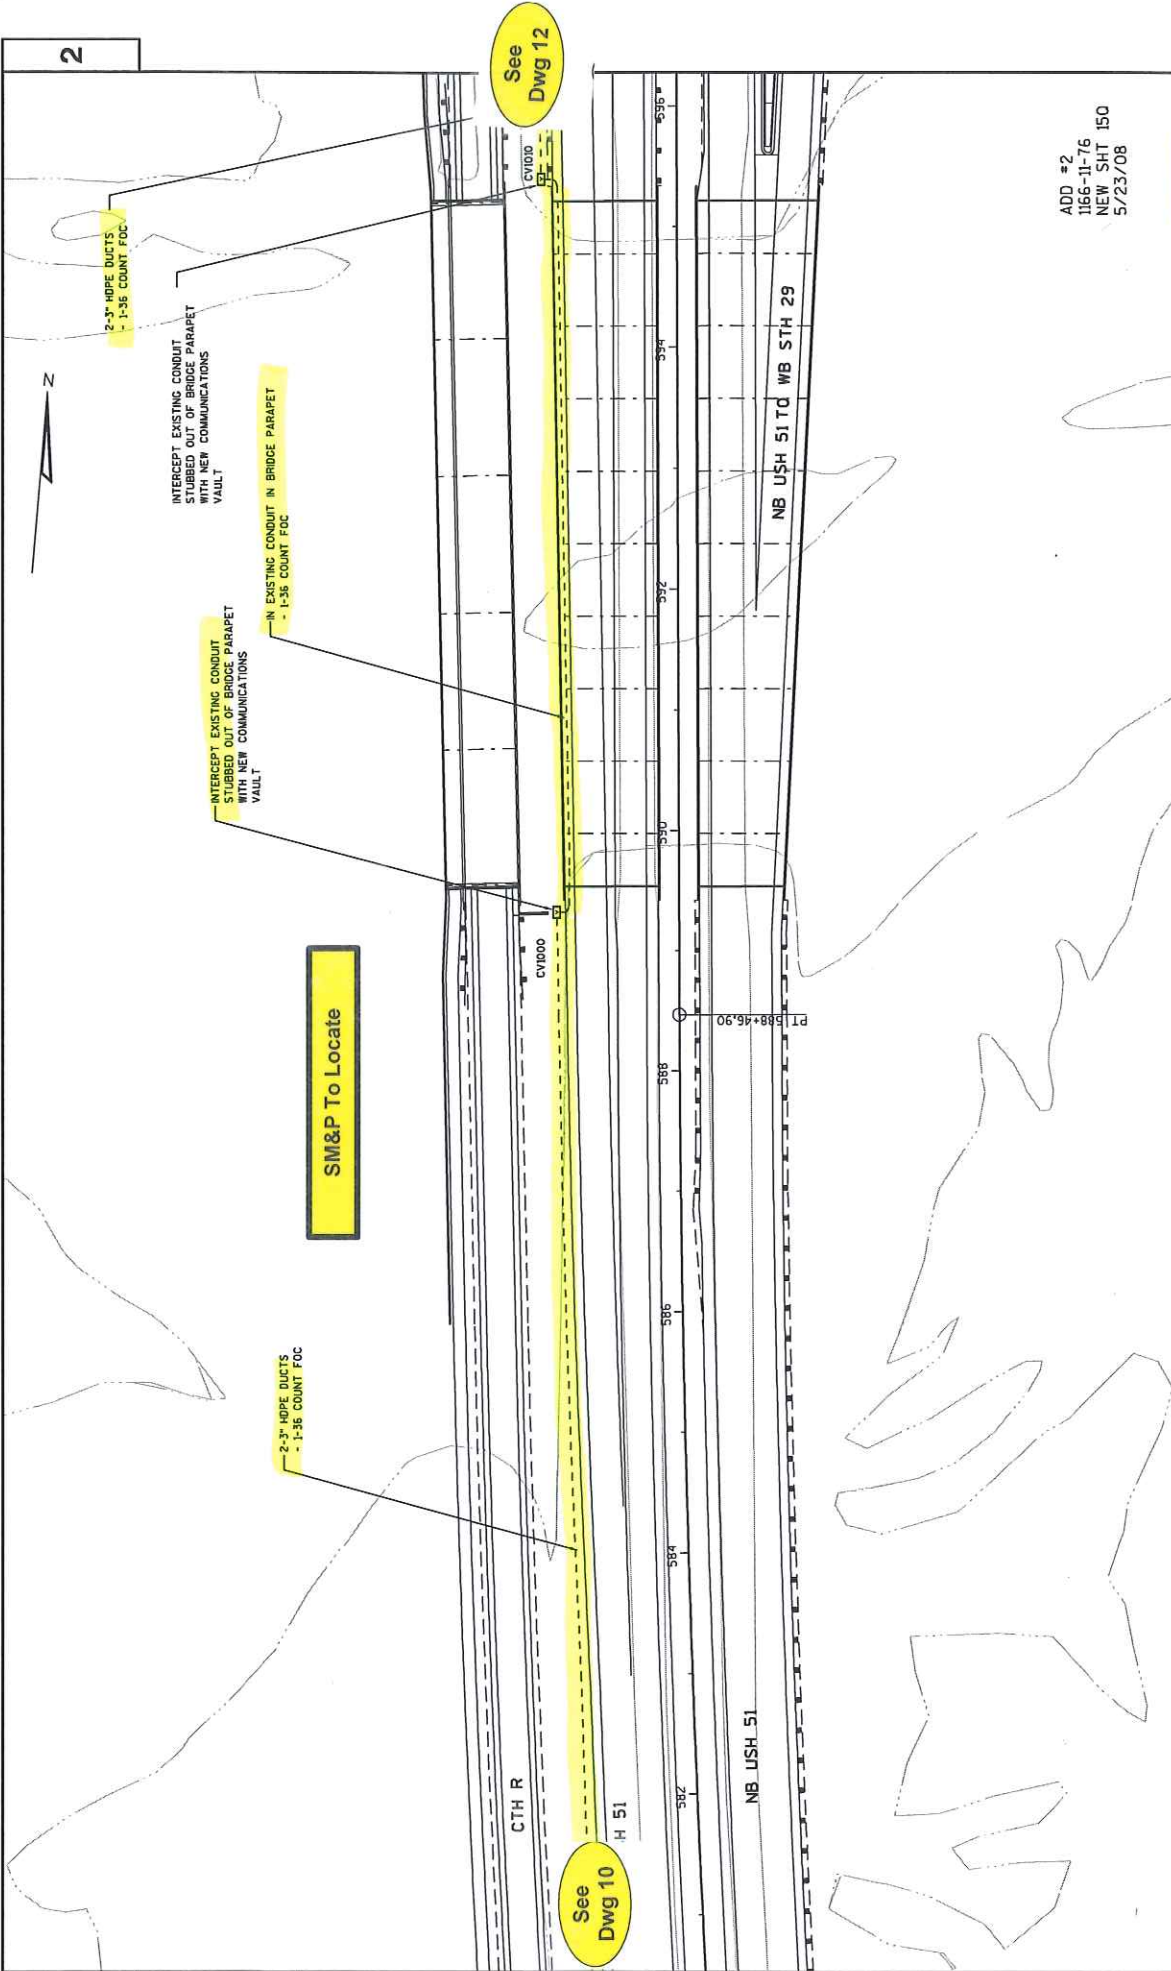

2

2



2-3" HDPE DUCTS  
- 1-36 COUNT FOC

INTERCEPT EXISTING CONDUIT  
STUBBED OUT OF BRIDGE PARAPET  
WITH NEW COMMUNICATIONS  
VAULT

INTERCEPT EXISTING CONDUIT  
WITH NEW COMMUNICATIONS  
VAULT

IN EXISTING CONDUIT IN BRIDGE PARAPET  
- 1-36 COUNT FOC

2-3" HDPE DUCTS  
- 1-36 COUNT FOC

SM&P To Locate

See  
Dwg 12

See  
Dwg 10

CTH R

H 51

NB USH 51

NB USH 51 TD WB STH 29


PT 598+46.90

ADD #2  
1166-11-76  
NEW SHT 150  
5/23/08

PROJECT NO: 1166-11-76	HWY: USH 51 / STH 29	COUNTY: MARATHON	ITS PLANS	SHEET 11 OF 17	E
------------------------	----------------------	------------------	-----------	----------------	---

FILE NAME : I:\3553\WISDOT\CADD\085\085-ITS-010.dgn PLOT DATE : 22-MAY-2008 16:24 PLOT BY : pkrutz PLOT NAME : 100.000092:11.000000 WISDOT/CADD SHEET 42

2

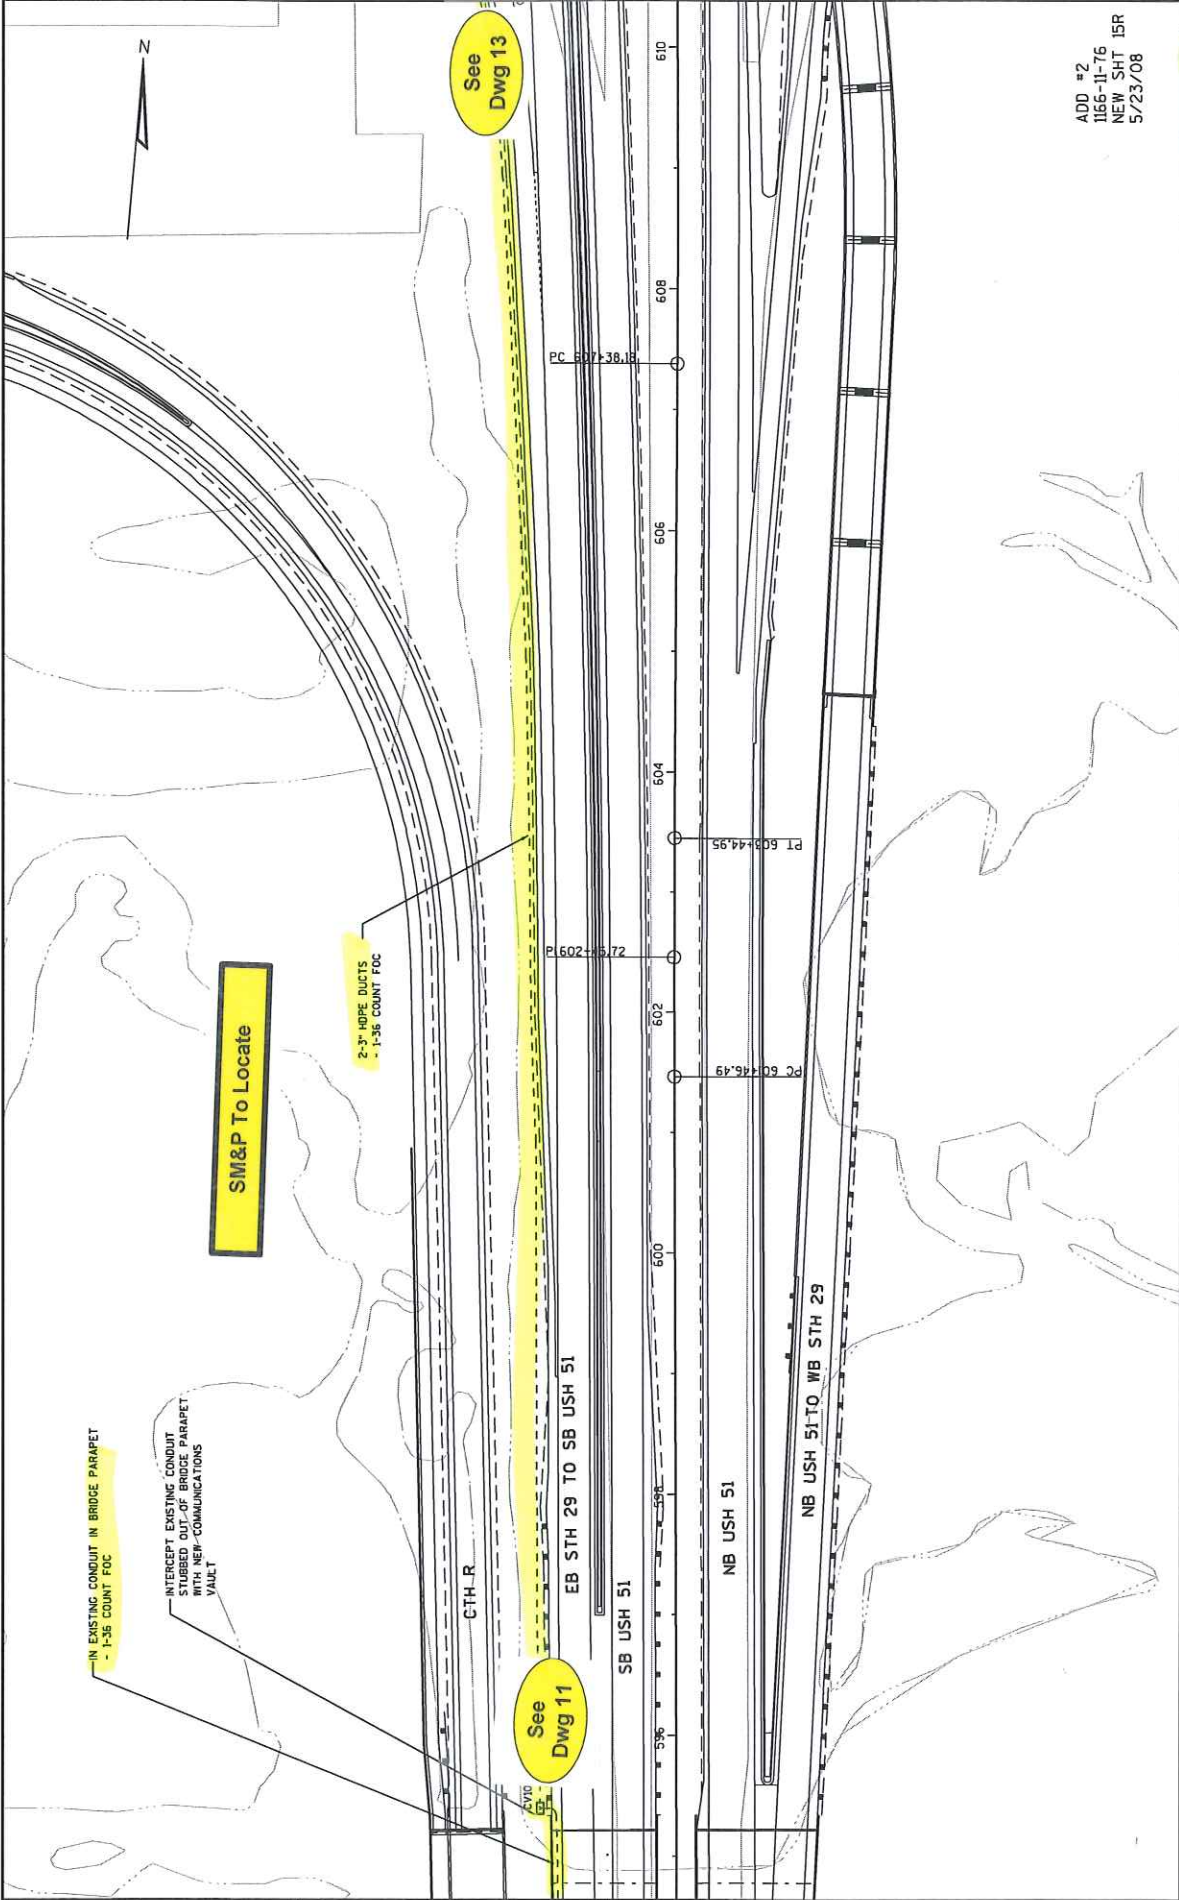


2

ADD #2  
 1166-11-76  
 NEW SHT ISR  
 5/23/08

PROJECT NO: 1166-11-76  
 HWY: USH 51 / STH 29  
 COUNTY: MARATHON  
 ITS PLANS  
 SHEET 120F17 E

FILE NAME : I:\V3553\NUGUN\0819\CAD\CADD\51S-015-011.dwg  
 PLOT DATE : 22-MAY-2008 18:28  
 PLOT BY : pkrutz  
 PLOT NAME :  
 PLOT SCALE : 100.00009211.000000  
 WISDOT/CADD SHEET 42

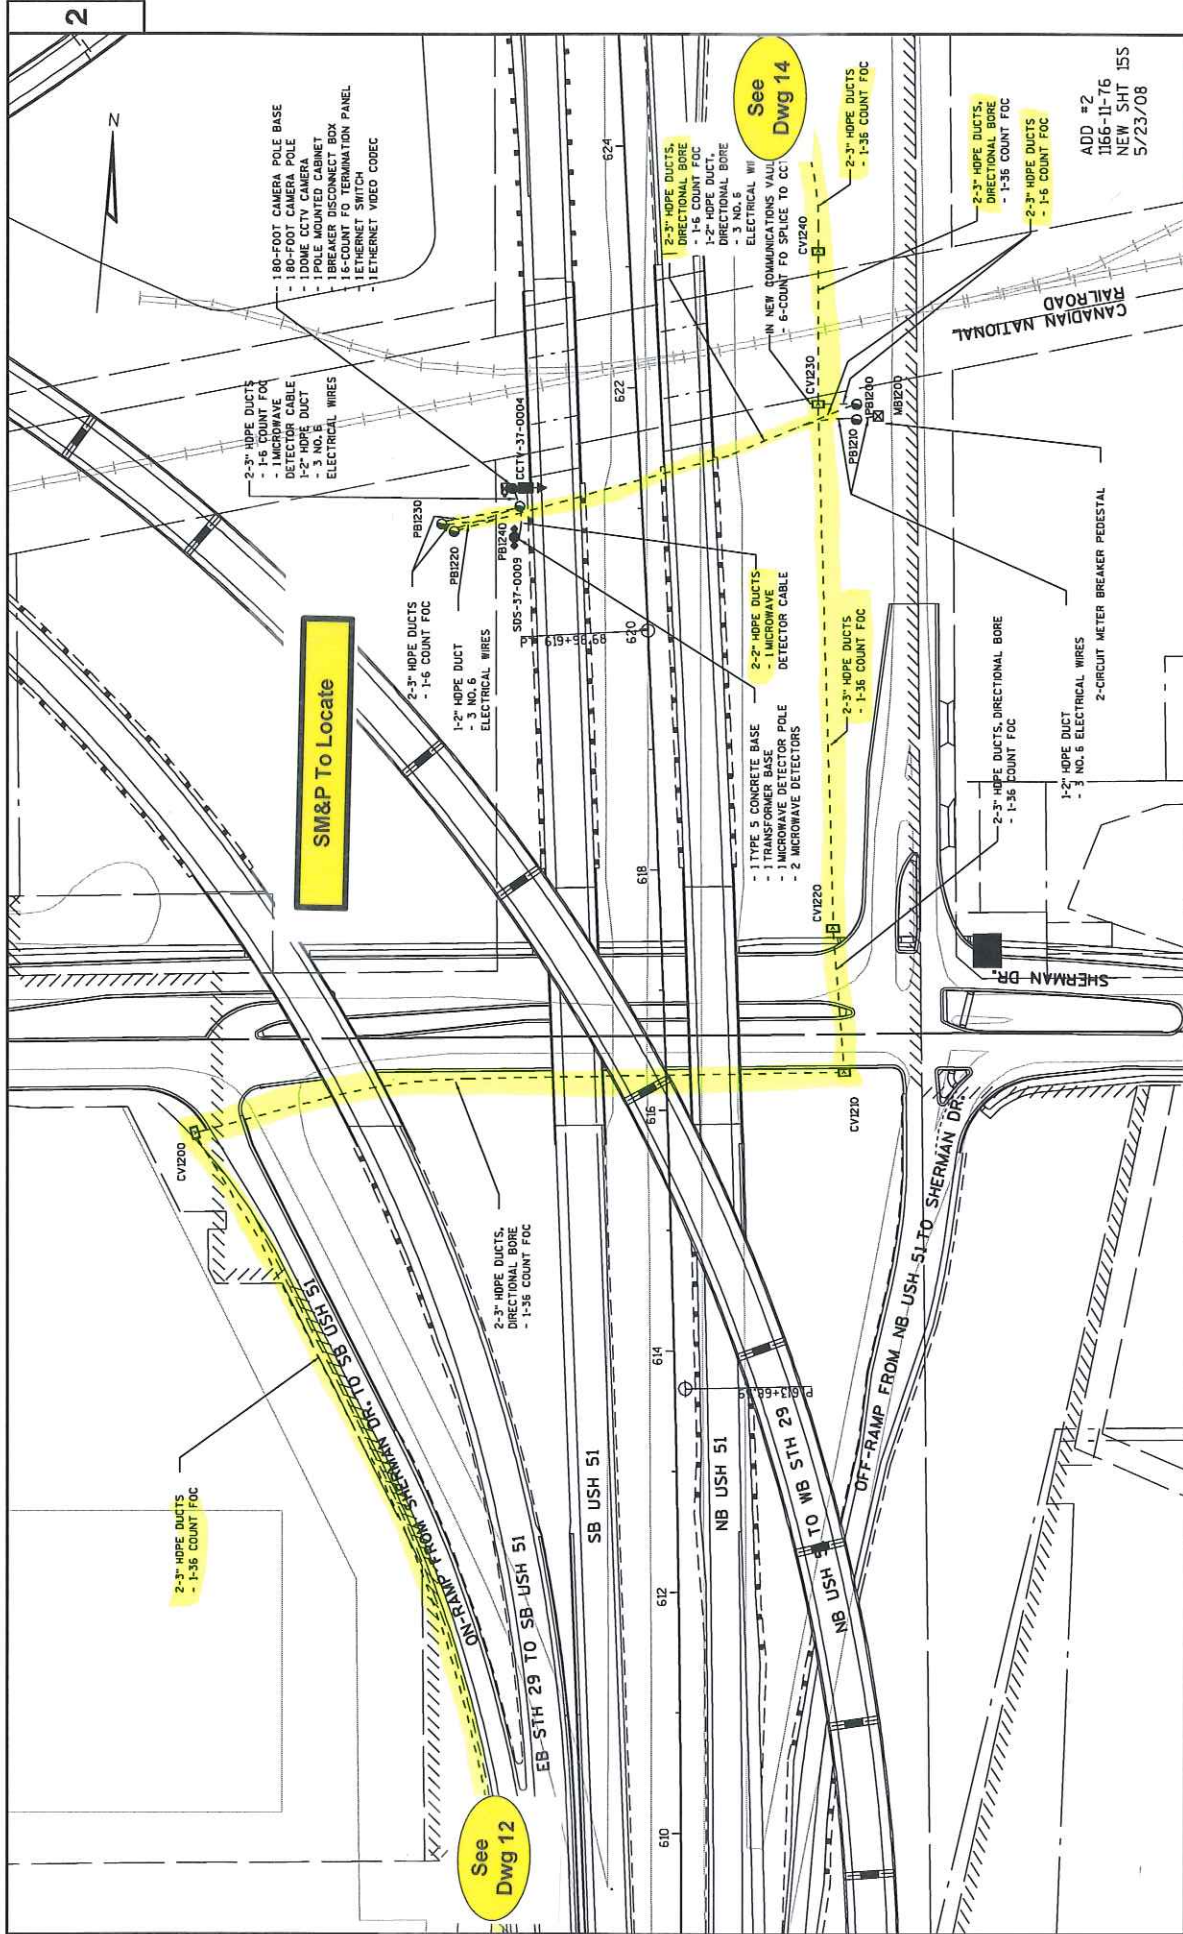

2-3" HOPE DUCTS  
- 1-36 COUNT FOC

2-3" HOPE DUCTS  
- 1-6 COUNT FOC  
- 180-FOOT CAMERA POLE  
- 180-FOOT CAMERA POLE  
- 1-2" HOPE DUCT  
- 3 NO. 6 ELECTRICAL WIRES

180-FOOT CAMERA POLE BASE  
- 180-FOOT CAMERA POLE  
- 1-2" HOPE DUCT  
- 3 NO. 6 ELECTRICAL WIRES  
- 1 BREAKER DISCONNECT BOX  
- 1-2" HOPE DUCT  
- 1 ETHERNET SWITCH  
- 1 ETHERNET VIDEO CODEC

**SM&P To Locate**

See Dwg 12

See Dwg 14

2-3" HOPE DUCTS  
- 1-36 COUNT FOC  
- 1-2" HOPE DUCT  
- 3 NO. 6 ELECTRICAL WIRES  
- 1-2" HOPE DUCT  
- 3 NO. 6 ELECTRICAL WIRES  
- 2 MICROWAVE DETECTORS

2-3" HOPE DUCTS,  
DIRECTIONAL BORE  
- 1-36 COUNT FOC  
- 1-2" HOPE DUCT  
- 3 NO. 6 ELECTRICAL WIRES

2-3" HOPE DUCTS,  
DIRECTIONAL BORE  
- 1-36 COUNT FOC  
- 1-2" HOPE DUCTS  
- 1-36 COUNT FOC

2-3" HOPE DUCTS,  
DIRECTIONAL BORE  
- 1-36 COUNT FOC  
- 1-2" HOPE DUCTS  
- 1-36 COUNT FOC

1-2" HOPE DUCT  
- 3 NO. 6 ELECTRICAL WIRES  
- 2-CIRCUIT METER BREAKER PEDESTAL

2-3" HOPE DUCTS,  
DIRECTIONAL BORE  
- 1-36 COUNT FOC

1-2" HOPE DUCT  
- 3 NO. 6 ELECTRICAL WIRES  
- 2-CIRCUIT METER BREAKER PEDESTAL

2-3" HOPE DUCTS,  
DIRECTIONAL BORE  
- 1-36 COUNT FOC

1-2" HOPE DUCT  
- 3 NO. 6 ELECTRICAL WIRES  
- 2-CIRCUIT METER BREAKER PEDESTAL

2-3" HOPE DUCTS,  
DIRECTIONAL BORE  
- 1-36 COUNT FOC

1-2" HOPE DUCT  
- 3 NO. 6 ELECTRICAL WIRES  
- 2-CIRCUIT METER BREAKER PEDESTAL

ADD #2  
1166-11-76  
NEW SHT 155  
5/23/08

PROJECT NO: 1166-11-76

COUNTY: MARATHON

HWY: USH 51 / STH 29

ITS PLANS


PLOT NAME :

PLOT DATE : 22-MAY-2008 16:27

PLOT BY : PHUTZ

PLOT SCALE : 100-000082:1:00000

WISDOT/CADD5 SHEET 42

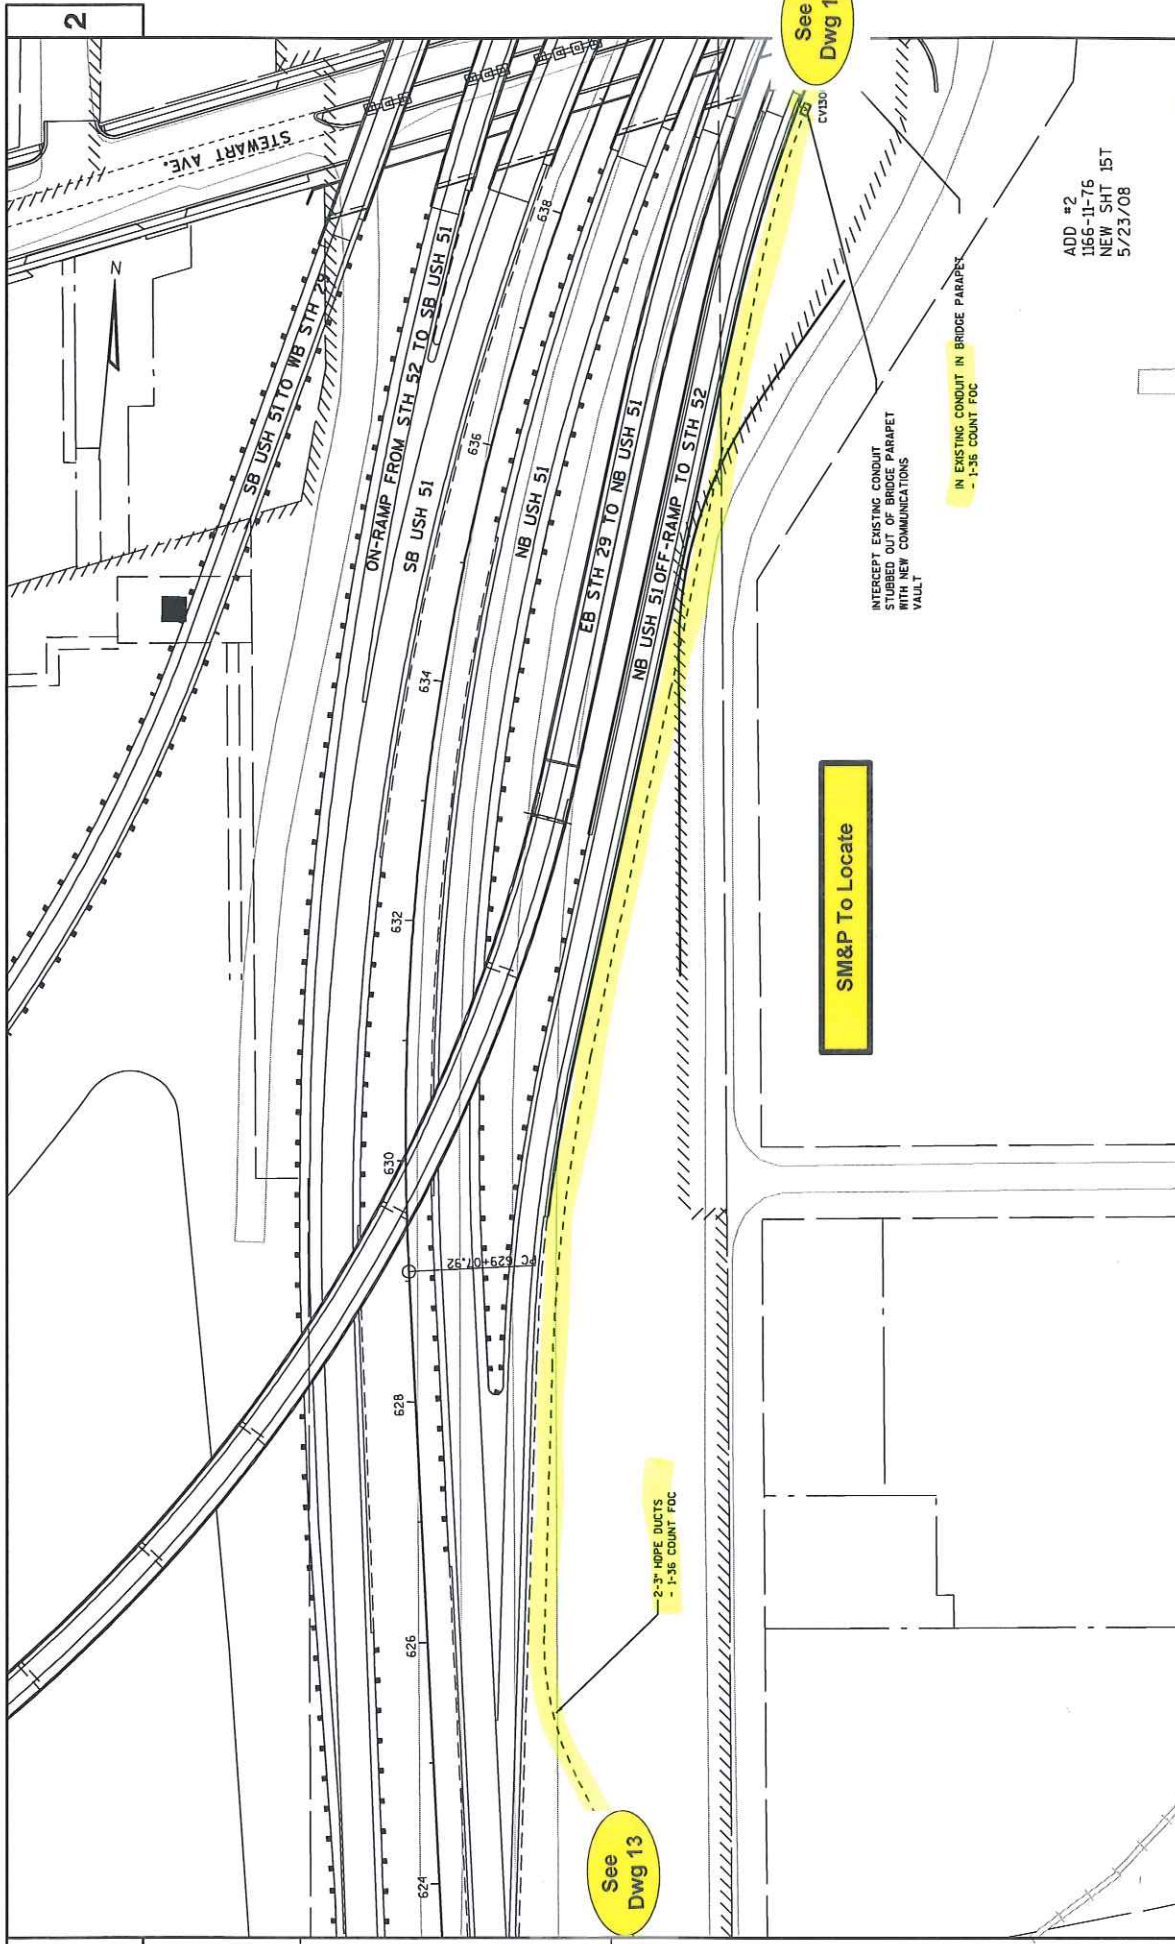

2

2


See  
Dwg 13

SM&P To Locate

See  
Dwg 15

ADD #2  
1166-11-76  
NEW SHT 15T  
5/23/08

PROJECT NO: 1166-11-76	HWY: USH 51 / STH 29	COUNTY: MARATHON	ITS PLANS	SHEET 140F17	E
FILE NAME : I:\33551\NAGS\0851\97\CADD\CDS\005-ITS_011.dgn					
PLOT DATE : 22-MAY-2008 16:30					
PLOT BY : DRGTZ					
PLOT NAME :					
PLOT SCALE : 100.000095:1.00000					
WISDOT/CADD'S SHEET 42					

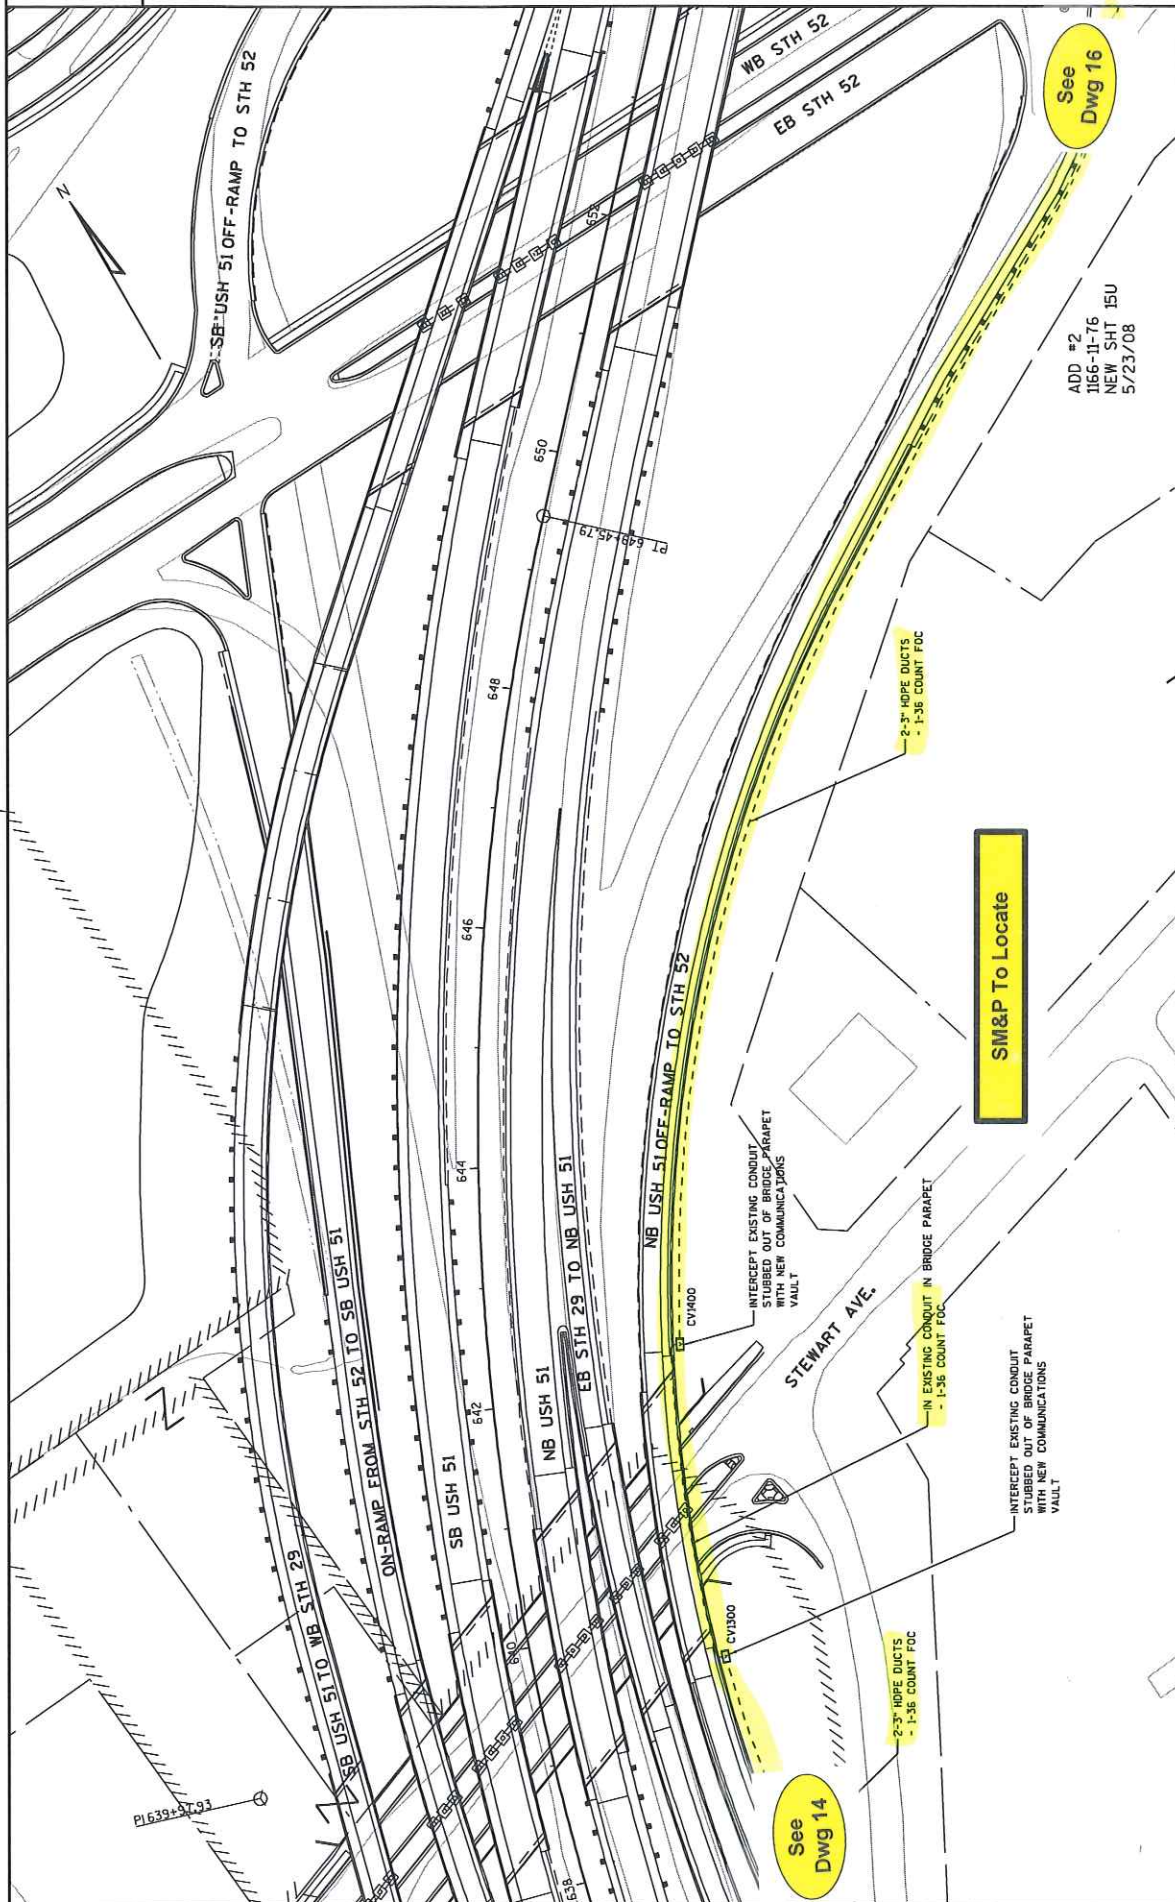


See Dwg 16

ADD #2  
1166-11-76  
NEW SHT 15U  
5/23/08

SM&P To Locate

See Dwg 14

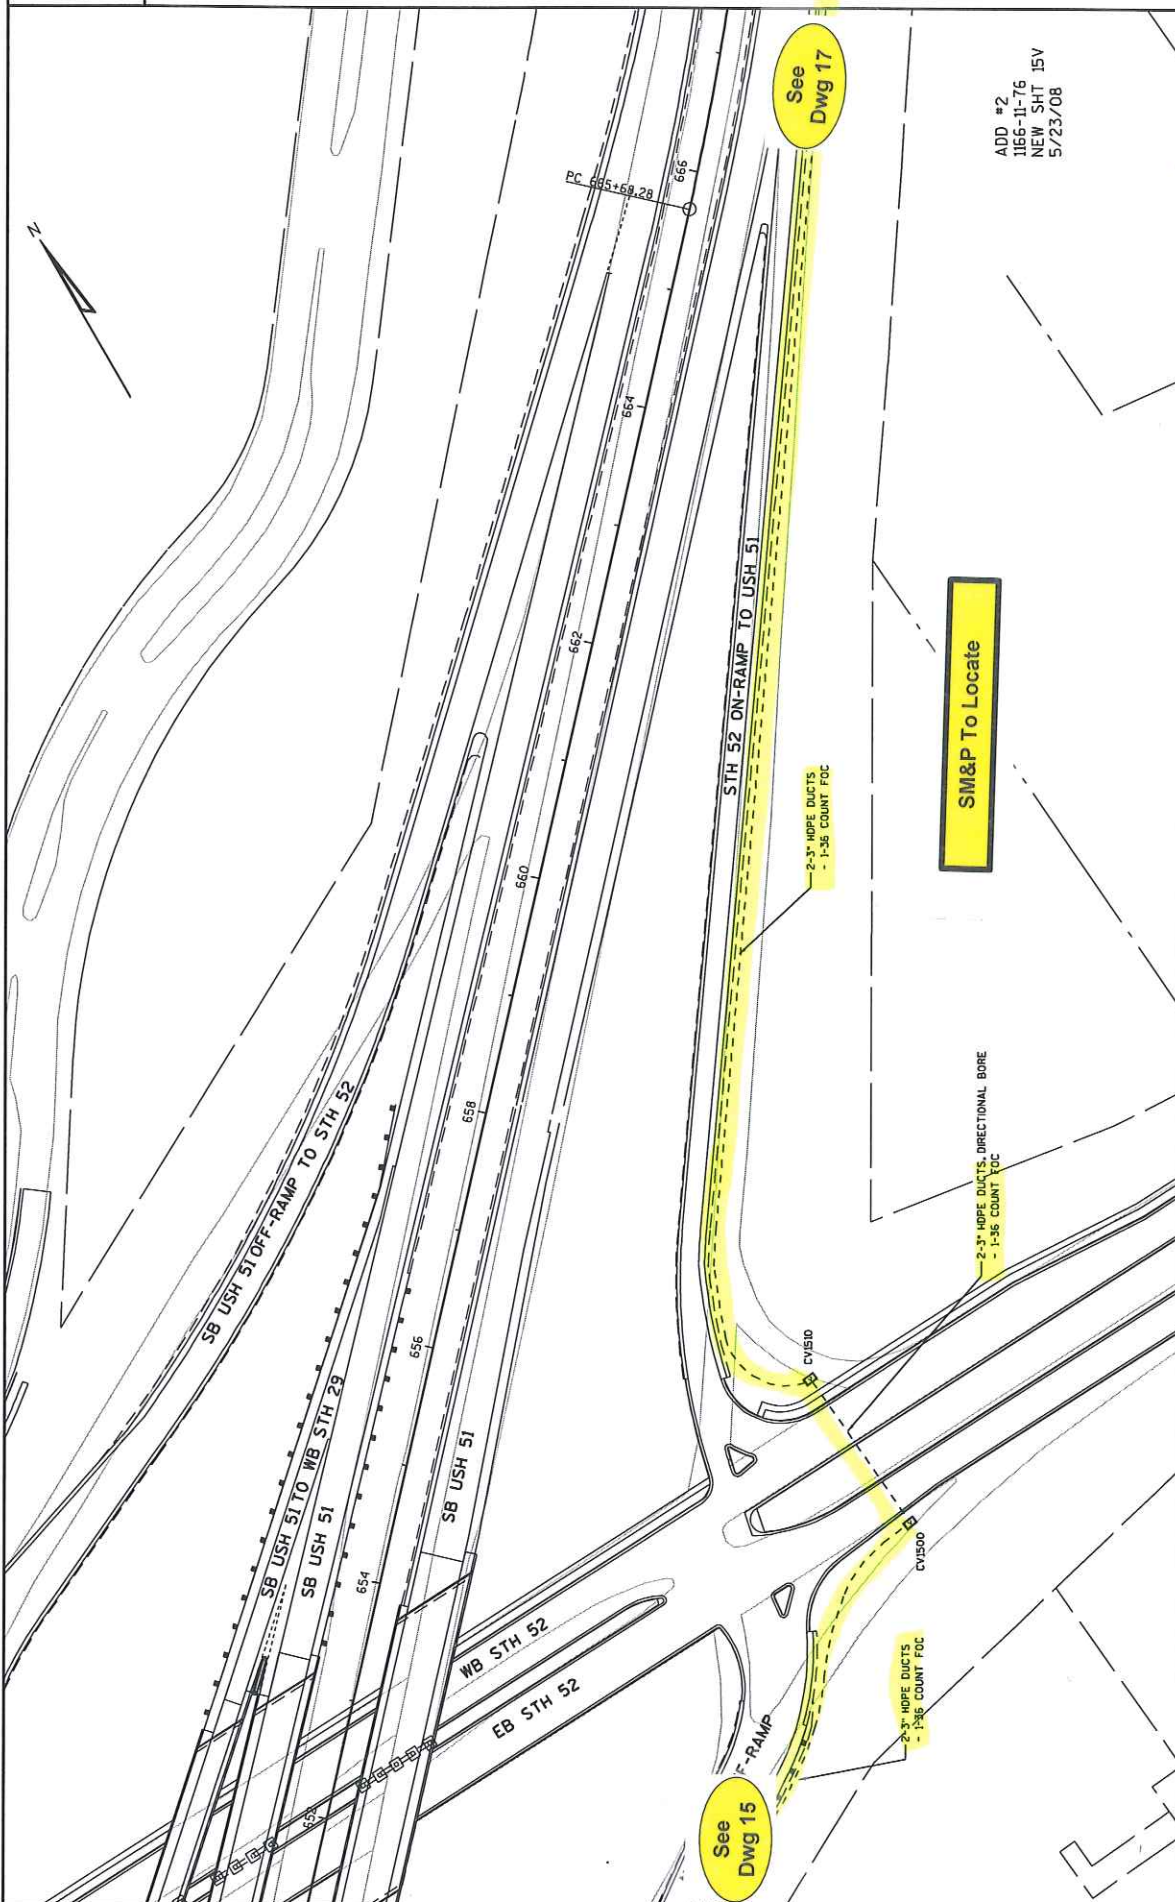


See Dwg 15

See Dwg 17

SM&P To Locate

ADD #2  
1166-11-76  
NEW SHT 15V  
5/23/08

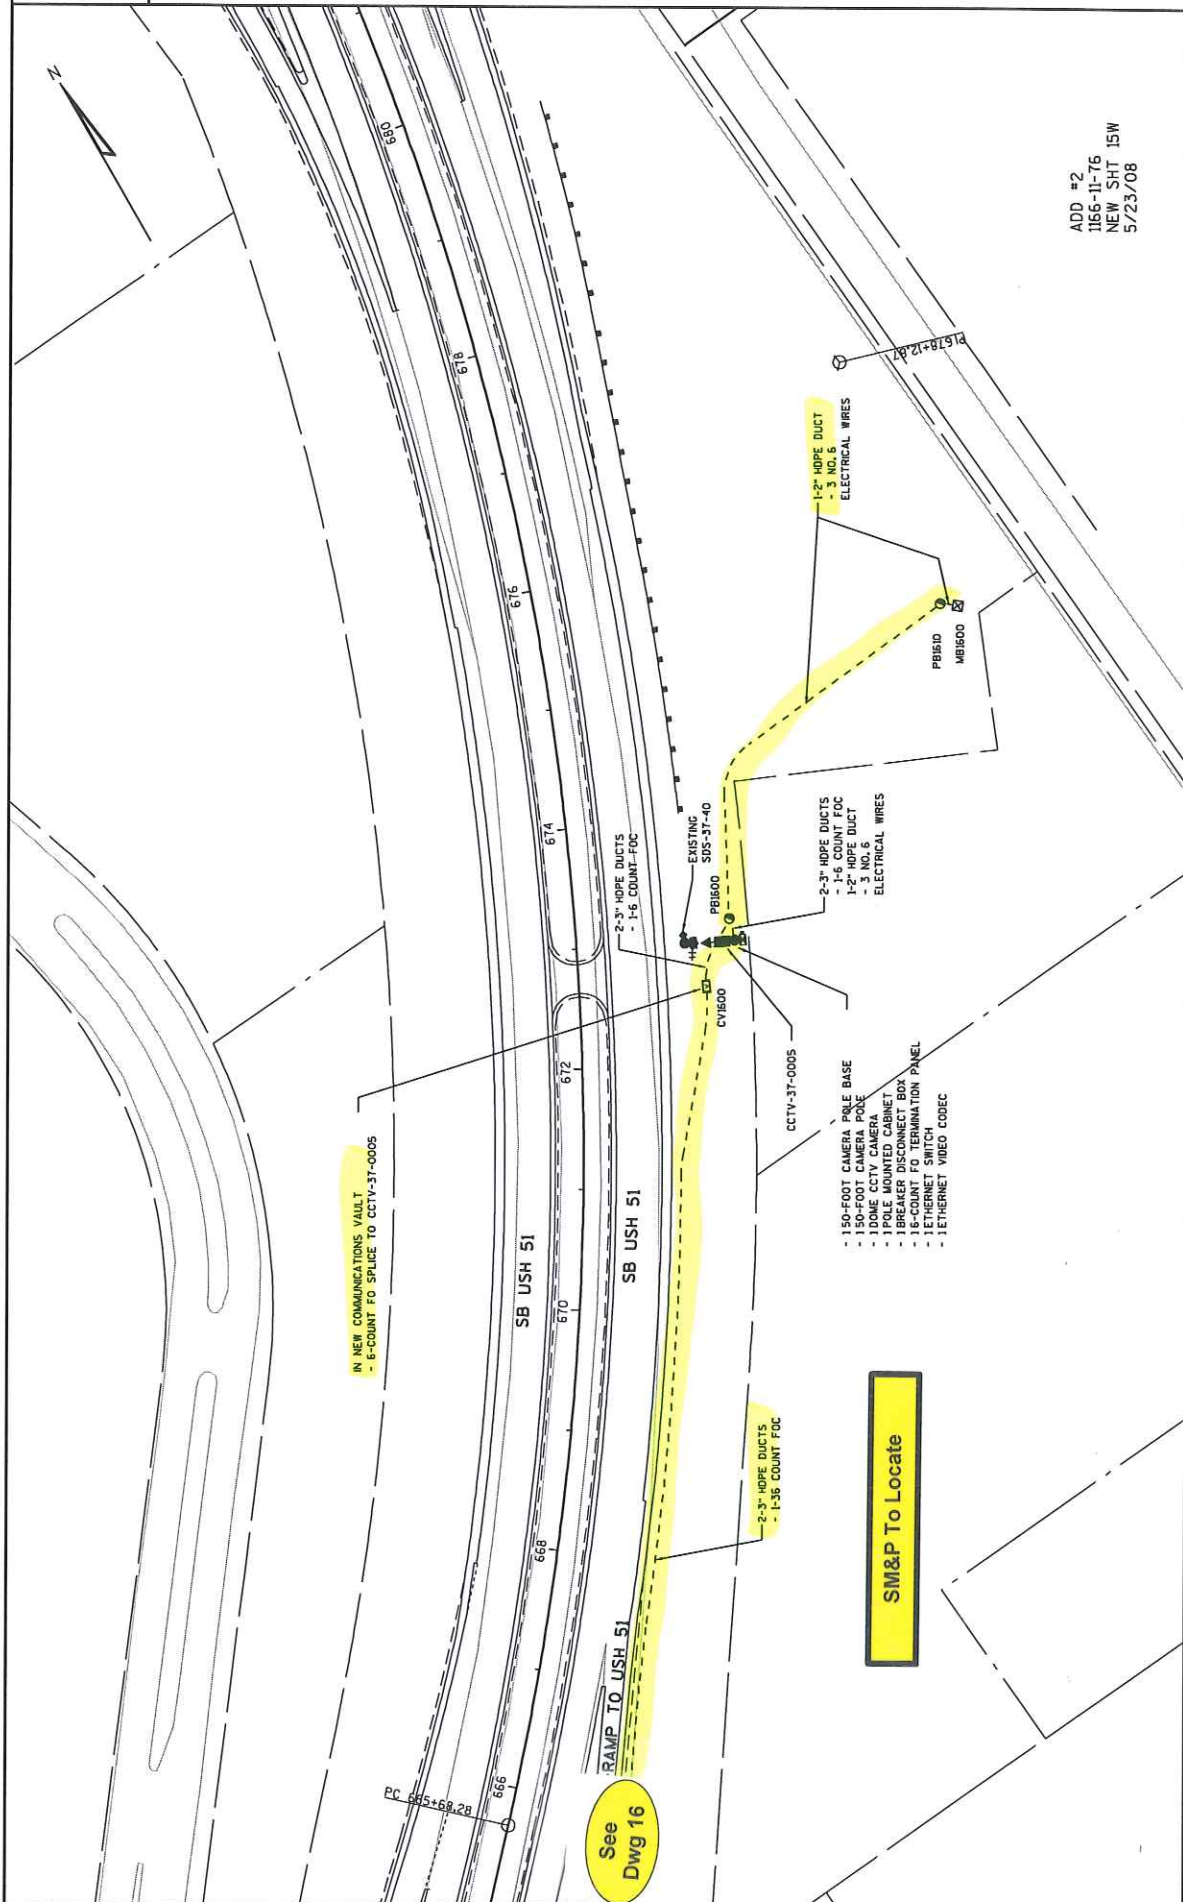

ADD #2  
1166-11-76  
NEW SHT 15W  
5/23/08

SHEET 17017  
E

PROJECT NO: 1166-11-76  
HWY: USH 51 / STH 29  
COUNTY: MARATHON  
ITS PLANS

PLOT DATE : 22-MAY-2008 16:36  
PLOT BY : DKUTZ

PLOT SCALE : 100.000049:1.00000  
WISDOT/CADD S SHEET 42

See  
Dwg 16